


T. 41 S., R. 8 W., W. M.

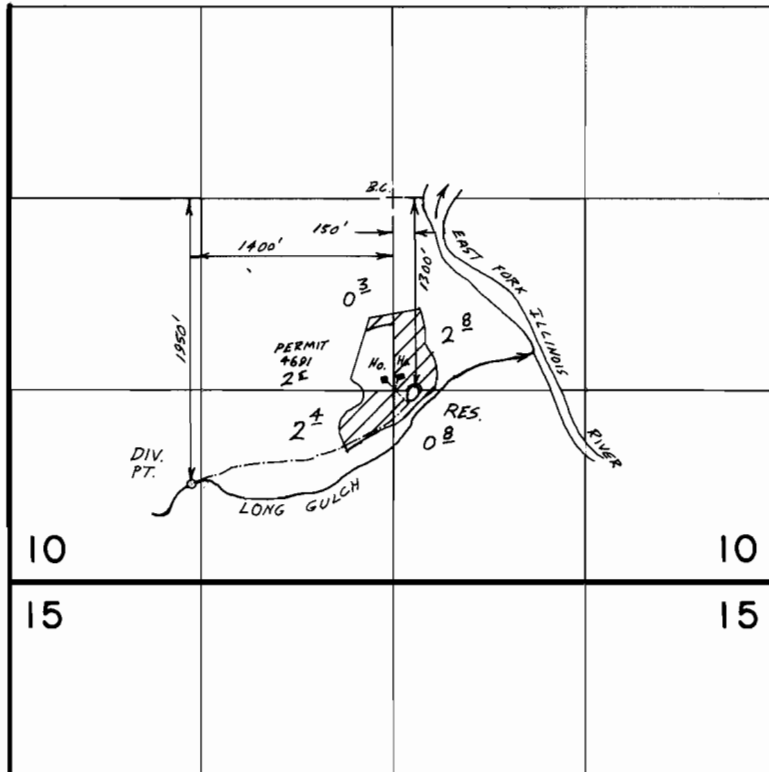

Scale: 1" = 1320'

FINAL PROOF SURVEY

UNDER

R-42949

R-4967

Application No. 42950 Permit No. 32370

IN NAME OF

LESLIE W. ORMSBY

Surveyed APR. 18, 1986, by B. S. JAMES