


T. 41 S., R. 8 W., W. M.

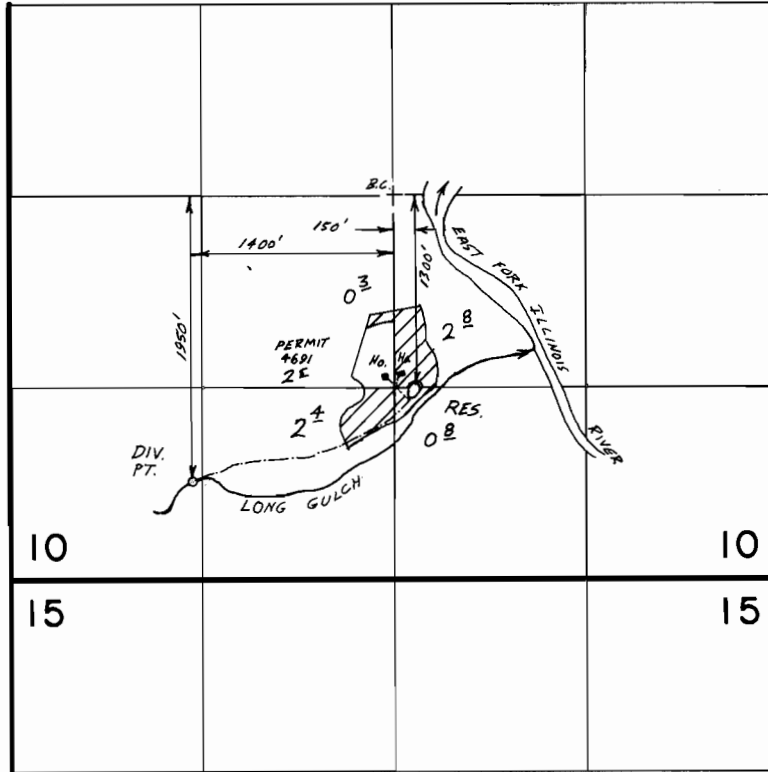

Scale: 1" = 1320'

**FINAL PROOF SURVEY**  
UNDER

R-42949      R-4967

Application No. 42950 Permit No. 32370

IN NAME OF

.....LESLIE W. ORMSBY.....

Surveyed APR. 18, 1986, by B. S. JAMES.....