


T. 2N., R. 3W., W.M.

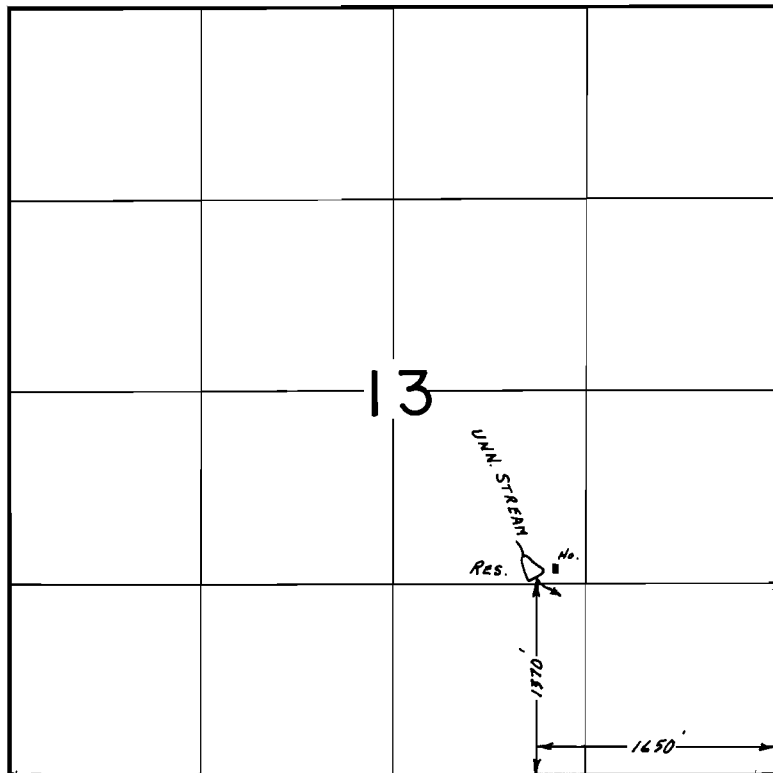

FINAL PROOF SURVEY
UNDER

R-51508 R-6069
Application No. 52007 Permit No. 37352
IN NAME OF

THOMAS J. JENKINS

Surveyed JULY 22 1980, by R.G. MUCKEN