


T.6S.,R.7W.,W.M.

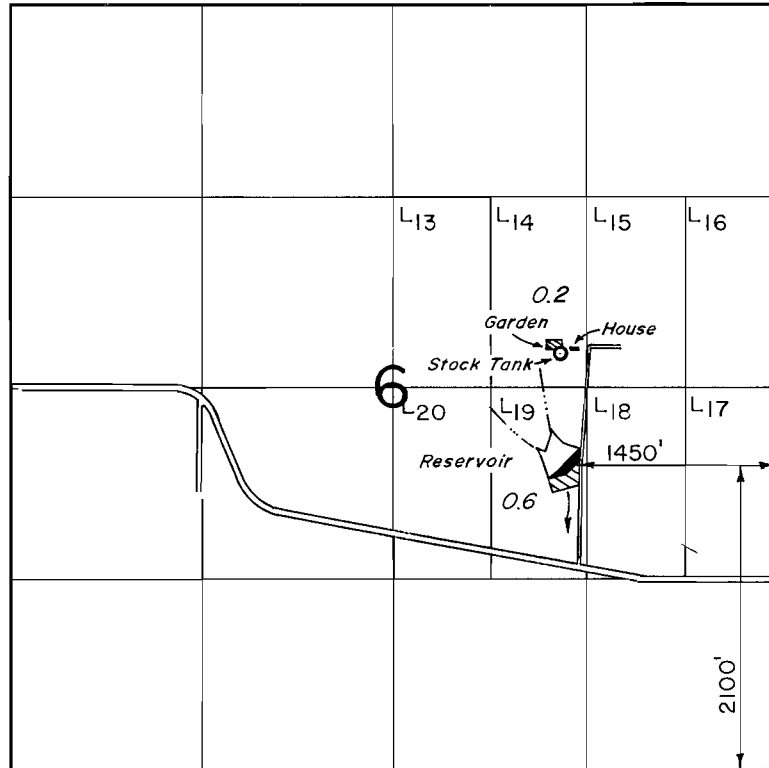

FINAL PROOF SURVEY UNDER

Application No. ⁵³³⁷⁴ R-53486 Permit No. ³⁸⁰⁷⁰ R-6156.....

IN NAME OF

J. W. FLEGAL

Surveyed JUNE 1, 1979, by *dl Brown*.....