


# T.6S.,R.7W.,W.M.

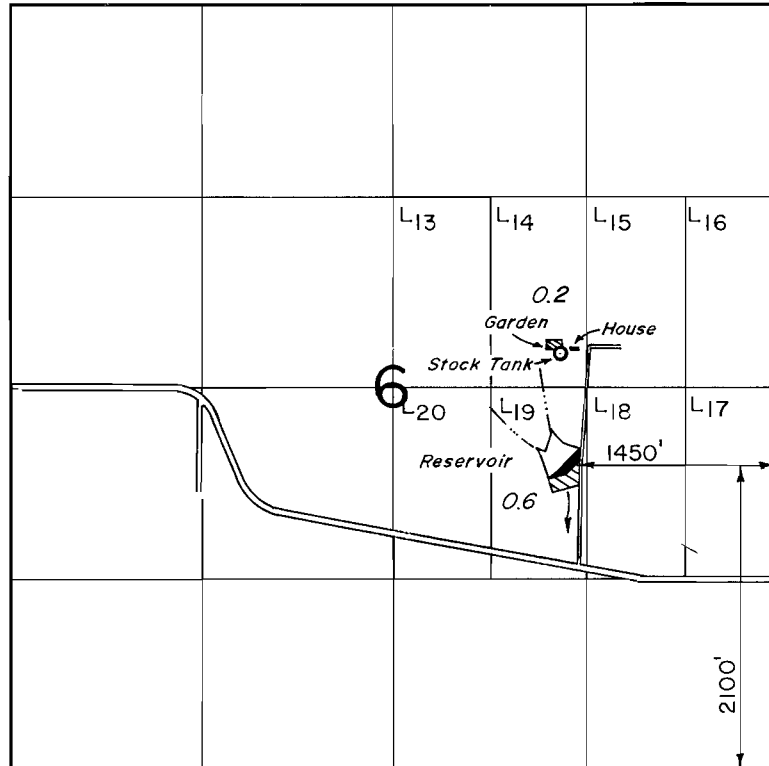

## FINAL PROOF SURVEY UNDER

Application No. <sup>53374</sup> R-53486 Permit No. <sup>38070</sup> R-6156.....

IN NAME OF

J. W. FLEGAL

Surveyed JUNE 1, 1979, by *dl Brown*.....