


T.26S.,R.4W.,W.M.

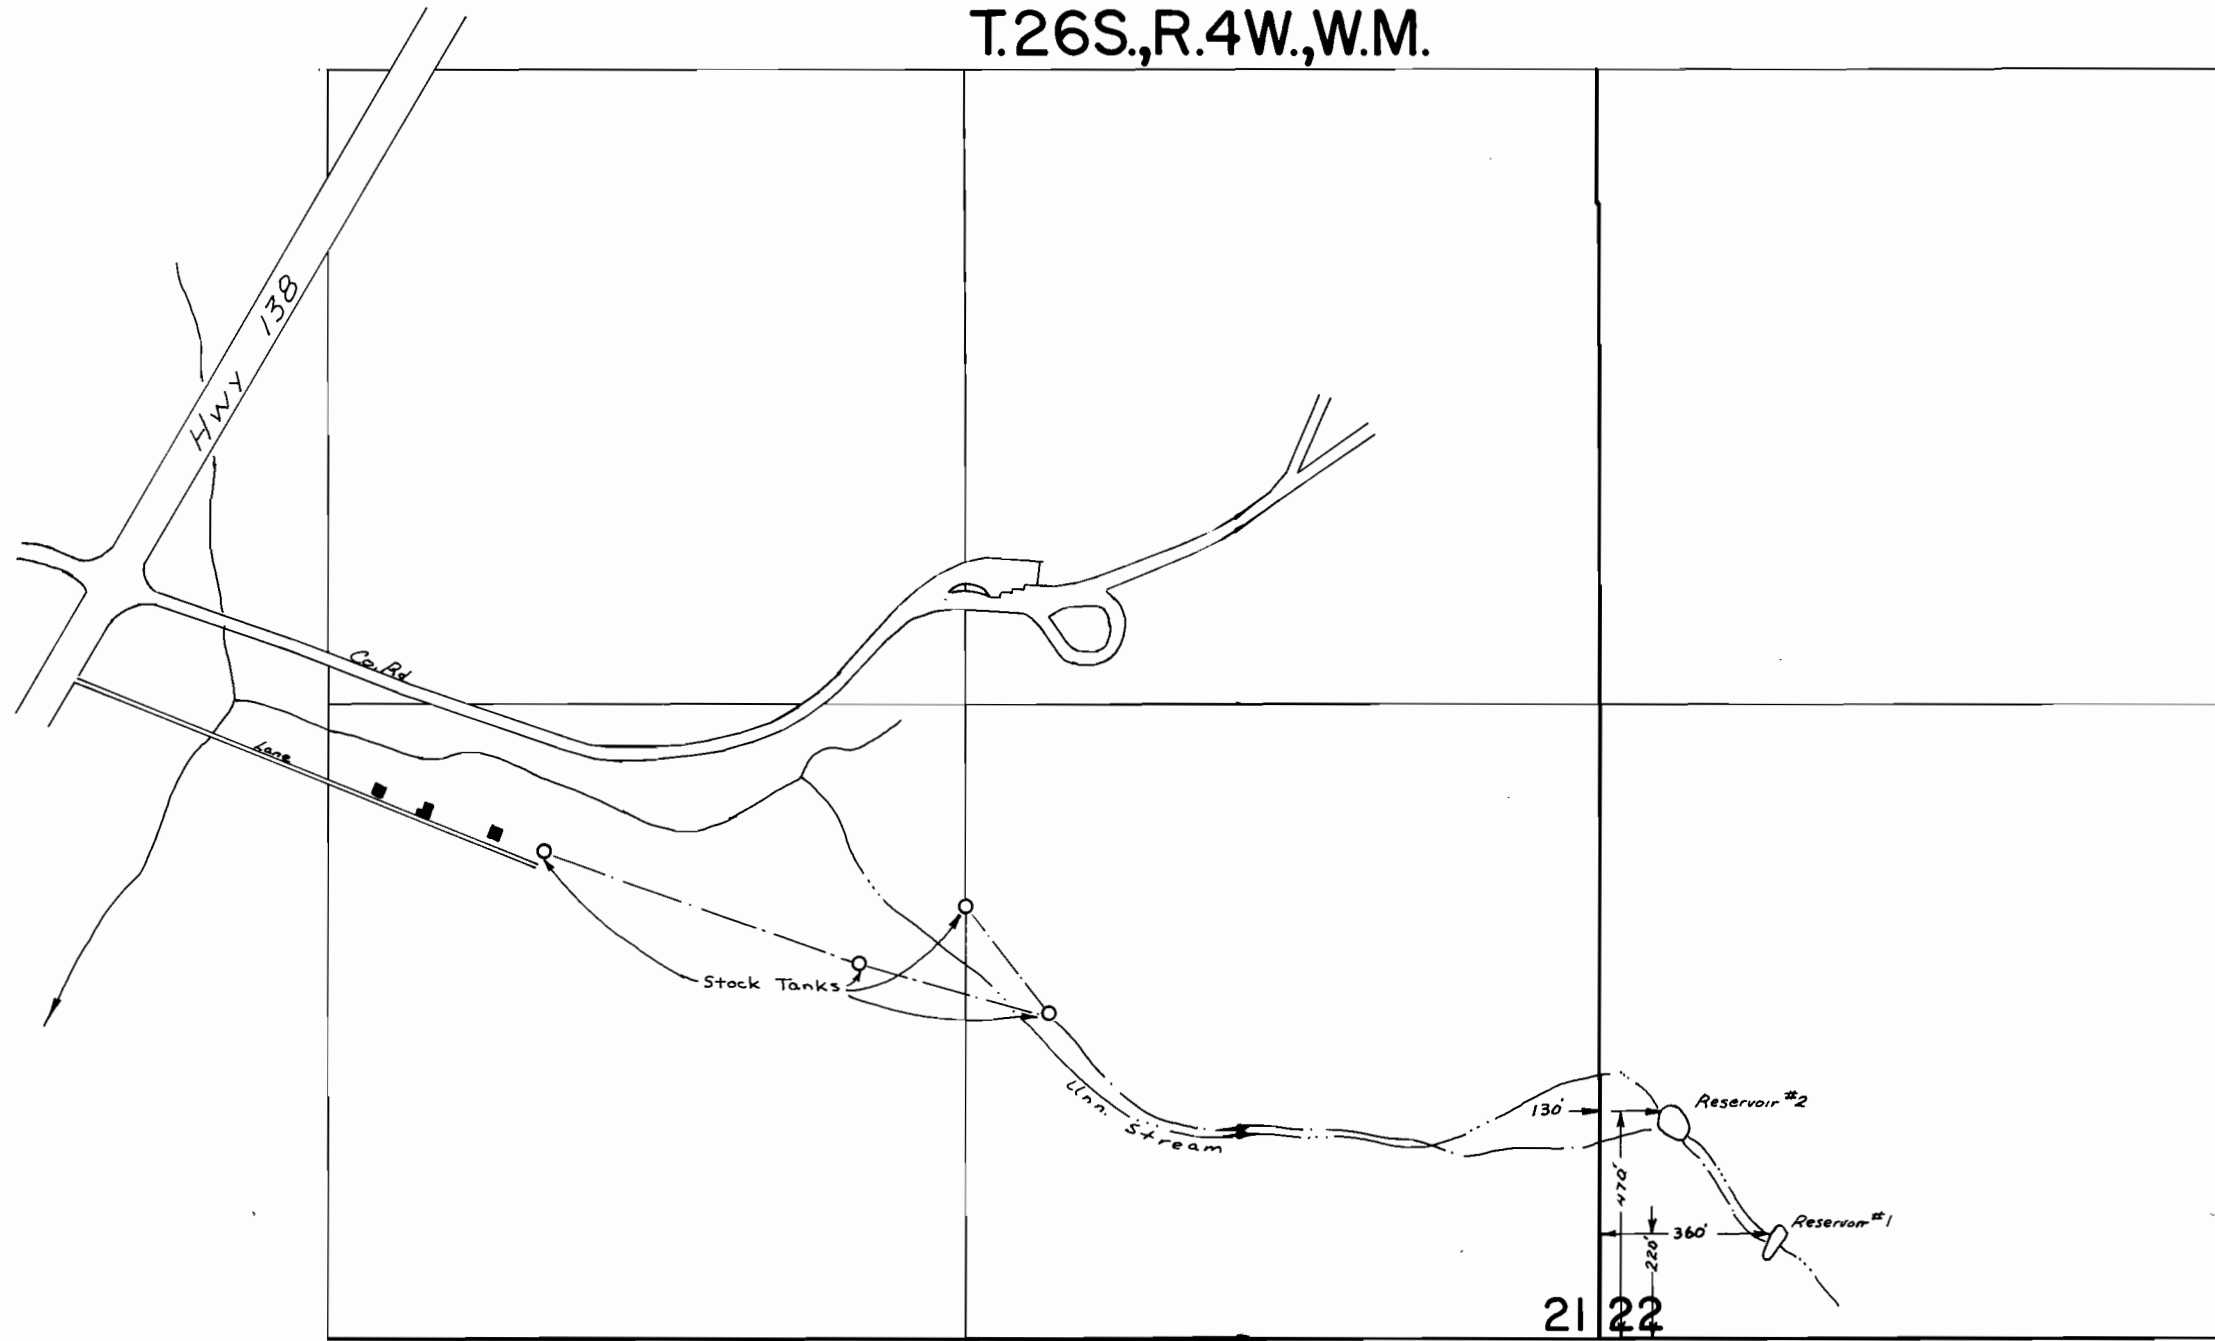

SCALE: 1" = 400'

FINAL PROOF SURVEY

OWNER
Application No. R-50013 Permit No. R-6251
50014 39107

IN NAME OF
COUNTY LAND DEPARTMENT

Surveyed Aug. 20, 1981, by L. M. TOLL