


T.26S.,R.4W.,W.M.

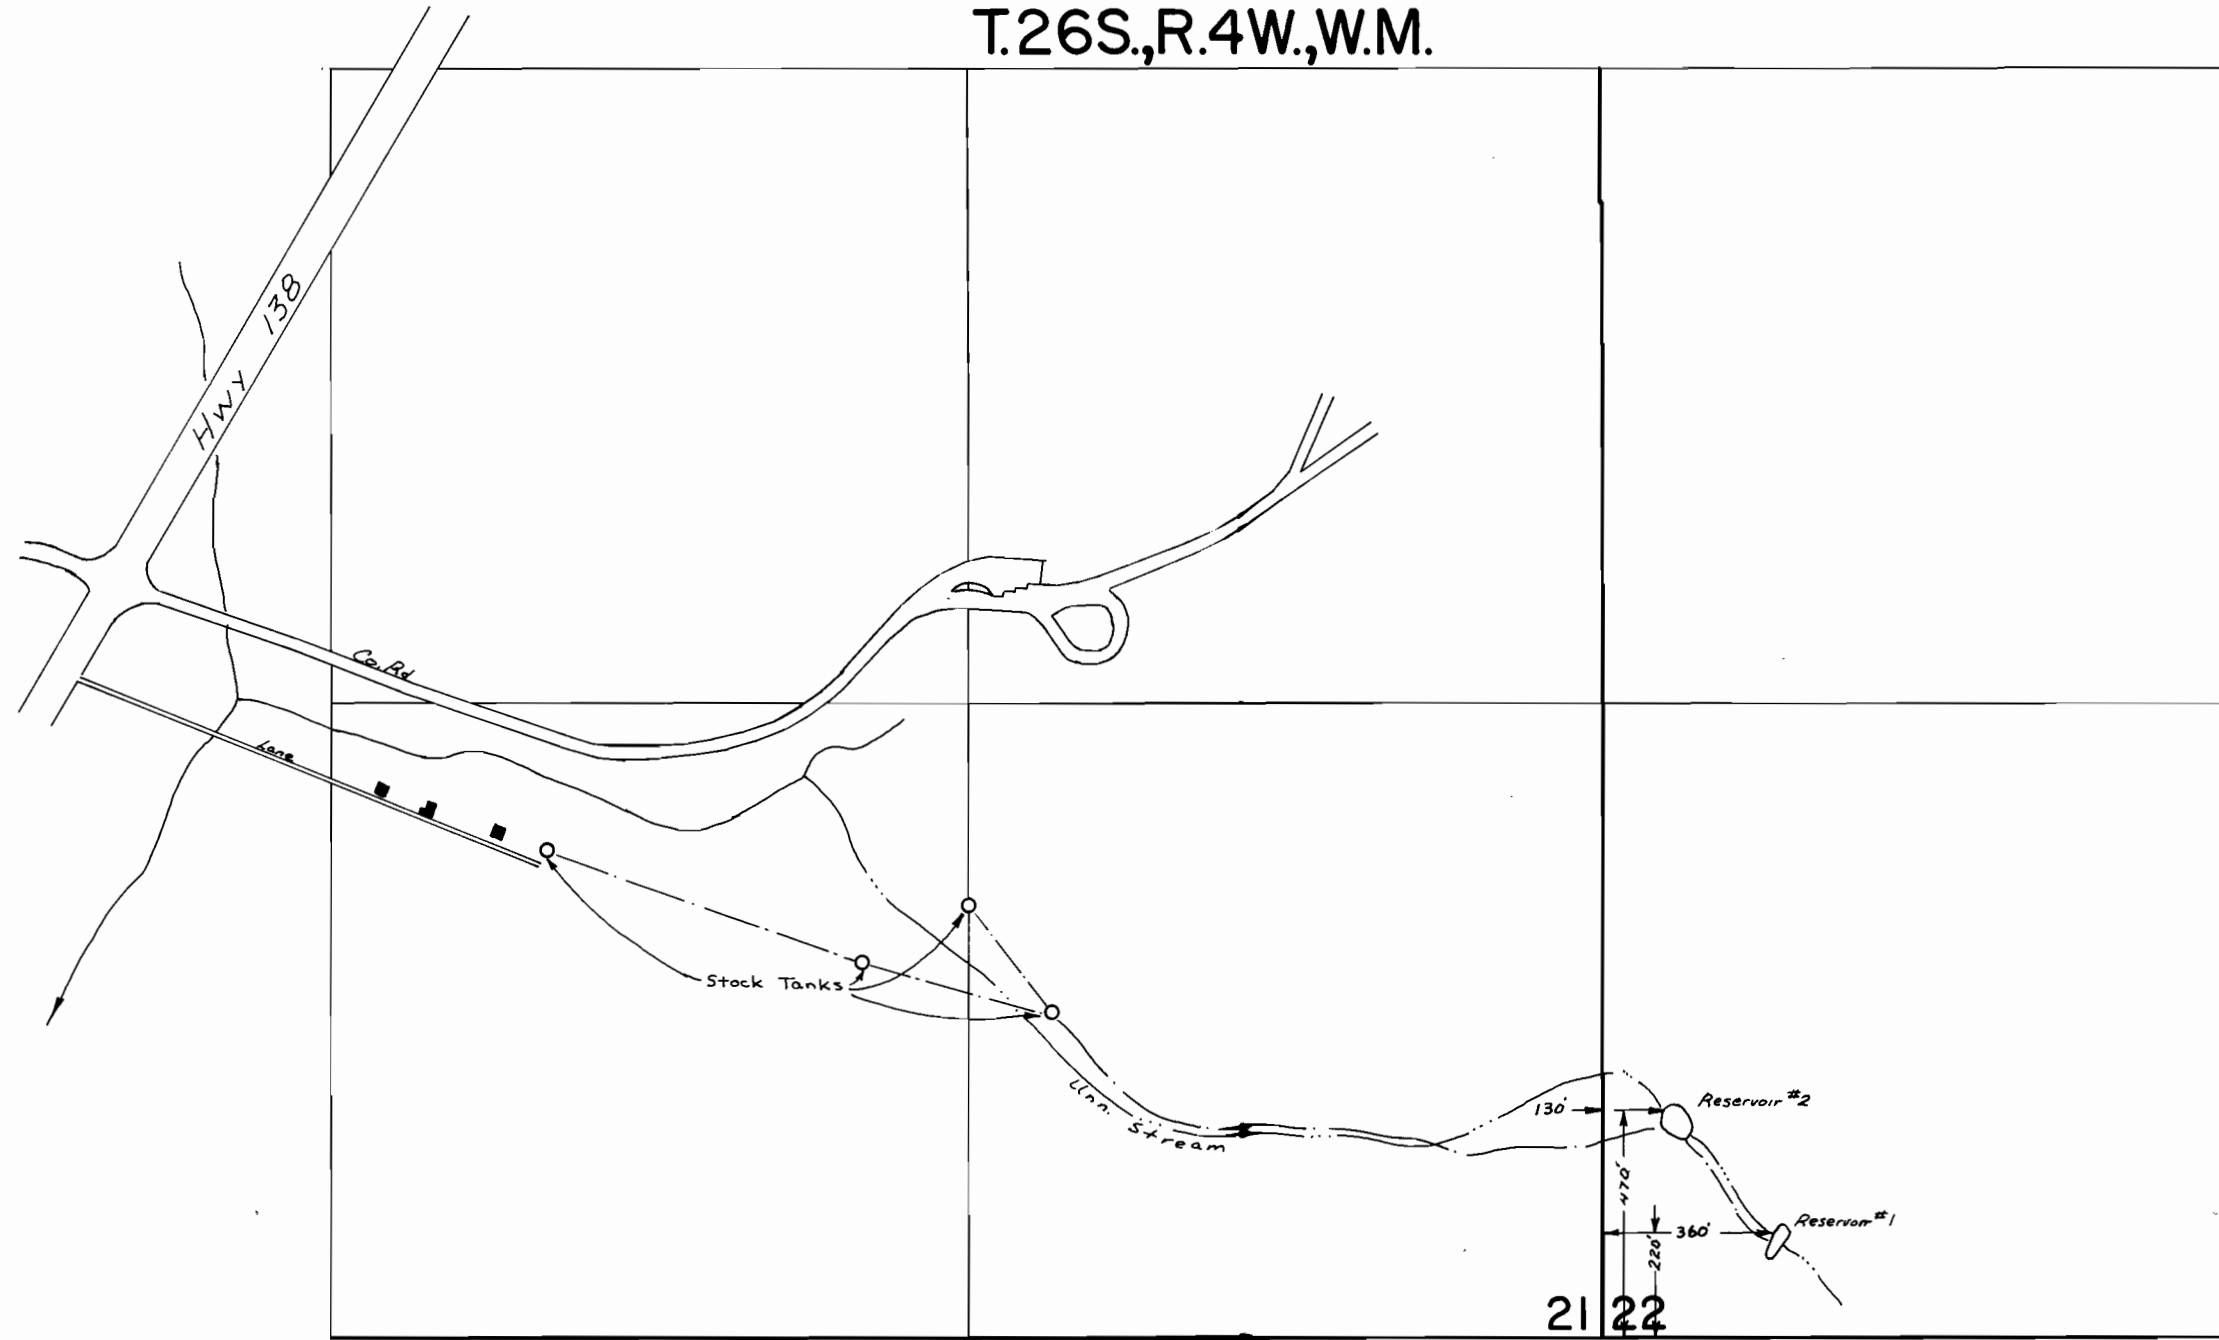

SCALE: 1" = 400'

**FINAL PROOF SURVEY**

UNDER  
R-50013 R-6251  
Application No. 5004 Permit No. 39107

IN NAME OF  
COUNTY LAND DEPARTMENT

Surveyed Aug. 20 1981, by L. M. TOLL