


39260
(R-6290)

57296
57295

T. 39 S., R. 4 E., W. M.

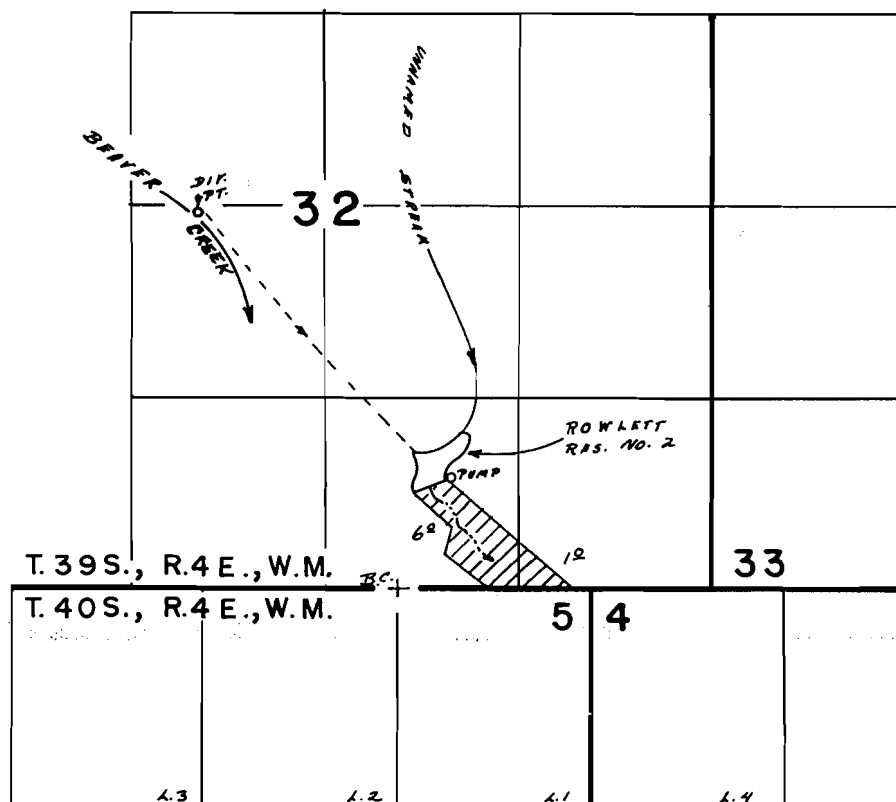

BEAVER CR. DIV:

2570 N., 1360' N.;

RESERVOIR:

700' N., 250' E.;

BOTH FROM N.W. CORNER
OF N¹/₄ N¹/₄ SEC. 5

FINAL PROOF SURVEY

UNDER

R-52114

R-6290

Application No. 52116 Permit No. 39260

IN NAME OF

DONALD ROWLETT

Surveyed SEP. 30. 1986, by B. S. JAMES.