


39260
(R-6290)

57296
57295

T. 39 S., R. 4 E., W. M.

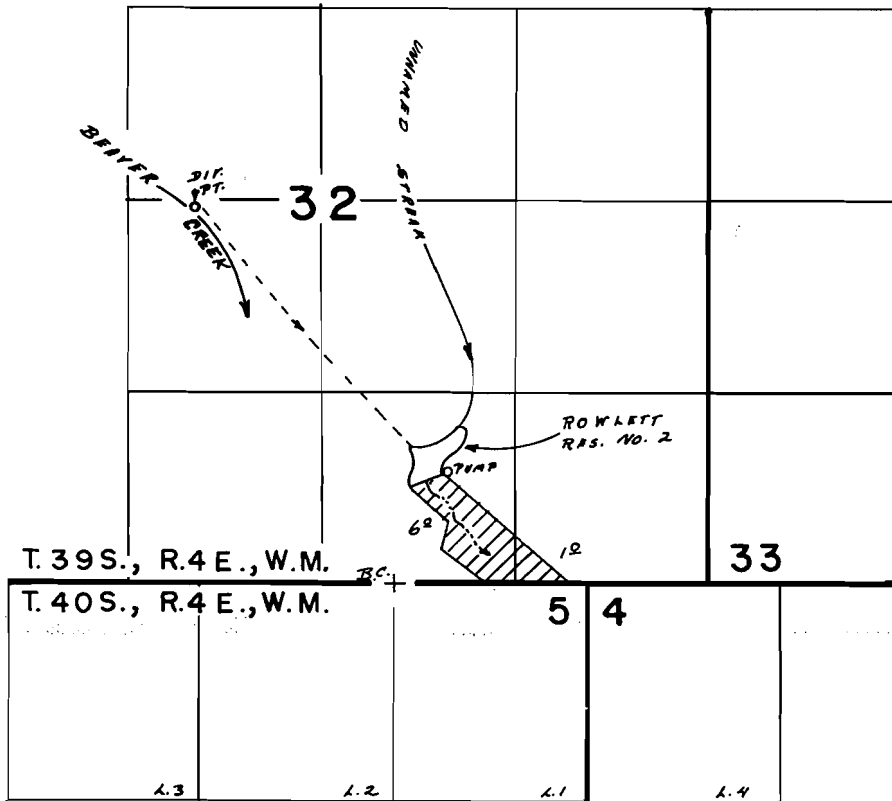

SCALE: 1"=1320'

BEAVER CR. DIV:

2570' N., 1360' N.;

RESERVOIR:

700' N., 250' E.;

BOTH FROM N.W. CORNER
OF NW 1/4 NW 1/4 SEC. 5

FINAL PROOF SURVEY

UNDER

R-52114

R-6290

Application No. 52116 Permit No. 39260

IN NAME OF

DONALD ROWLETT

Surveyed SEP. 30. 1986, by R. S. JAMES.