
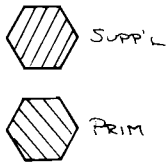


T.5S.,R.4W.,W.M.

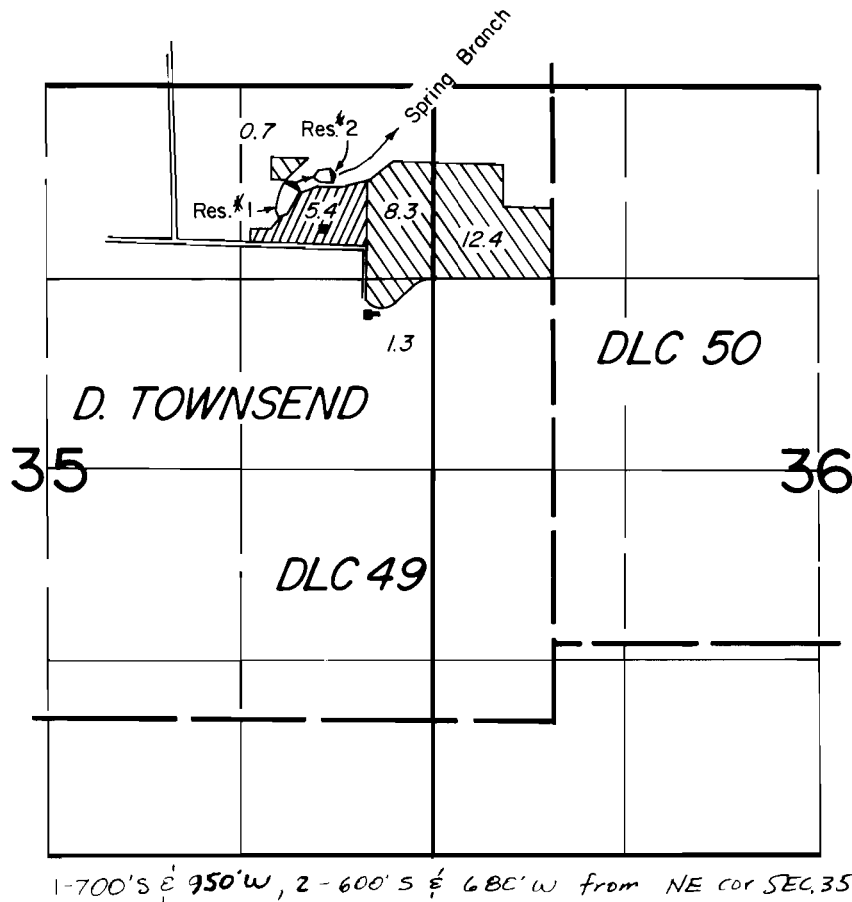

FINAL PROOF SURVEY UNDER

R-52930 R-6304
 Application No. 52931 Permit No. 39374.....

IN NAME OF

DENNIS M. BRUTKE

Surveyed JUNE 7, 1980, by [Signature]