


T8S. R5W. WM.

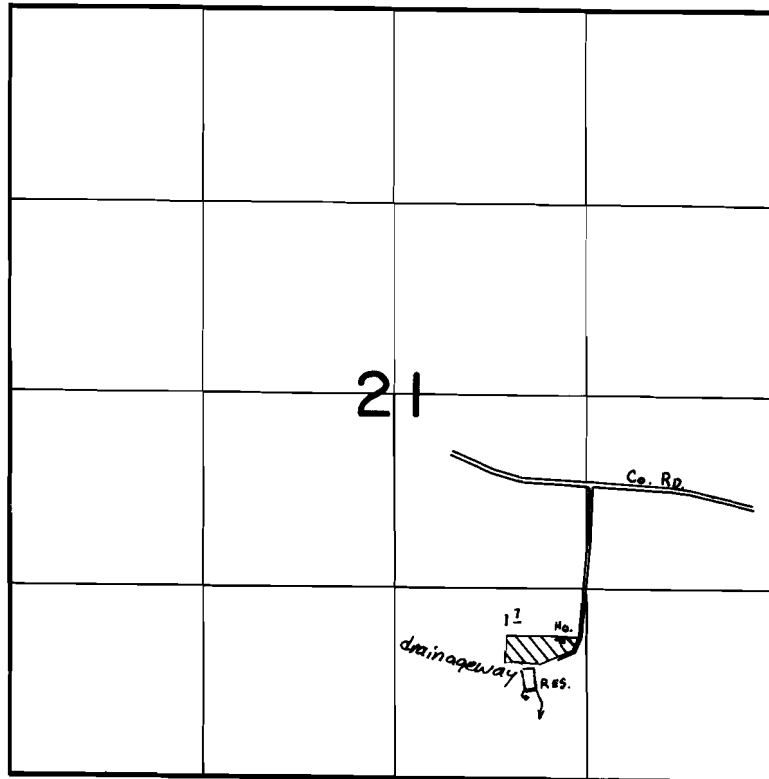

DAM Loc: 610' N. & 1700' W. fr. S.E. Cor. Sec. 21.

SPRING Loc: 770' N. & 1780' W. fr. S.E. Cor. Sec. 21.

**FINAL PROOF SURVEY**  
UNDER

R-52350                      R-6337  
Application No. 52351... Permit No. 39390.....  
IN NAME OF

.....**ALTON FALK**.....

Surveyed July 17, 1979, by C. L. HUGHES.....