


T8S. R5W. WM.

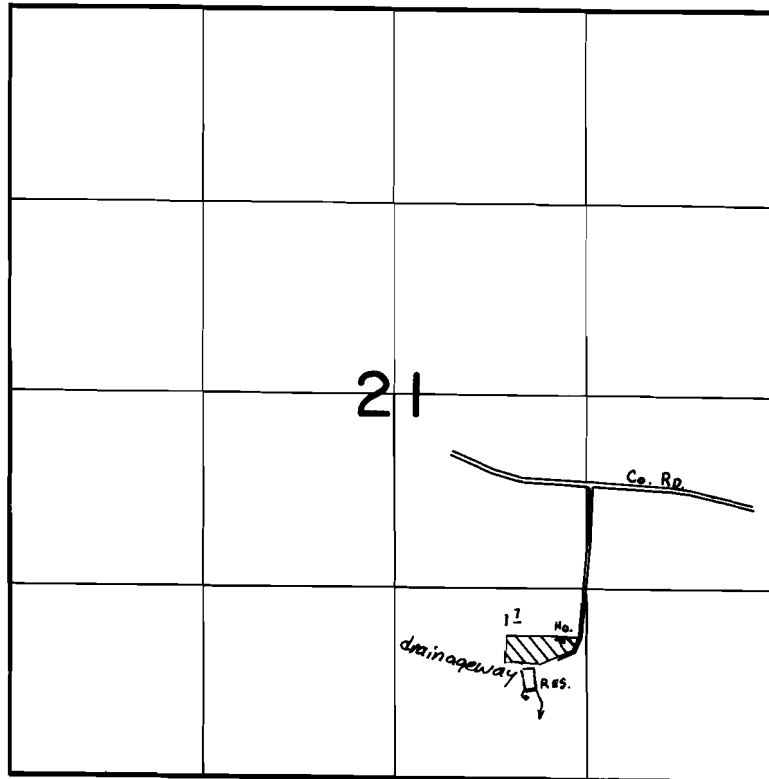

DAM Loc: 610' N. & 1700' W. fr. S.E. Cor. Sec. 21.

SPRING Loc: 770' N. & 1780' W. fr. S.E. Cor. Sec. 21.

FINAL PROOF SURVEY
UNDER

R-52350 R-6337
Application No. 52351... Permit No. 39390.....
IN NAME OF

.....**ALTON FALK**.....

Surveyed July 17, 1979, by C. L. HUGHES.....