


# T.4S.,R.3E.,W.M.

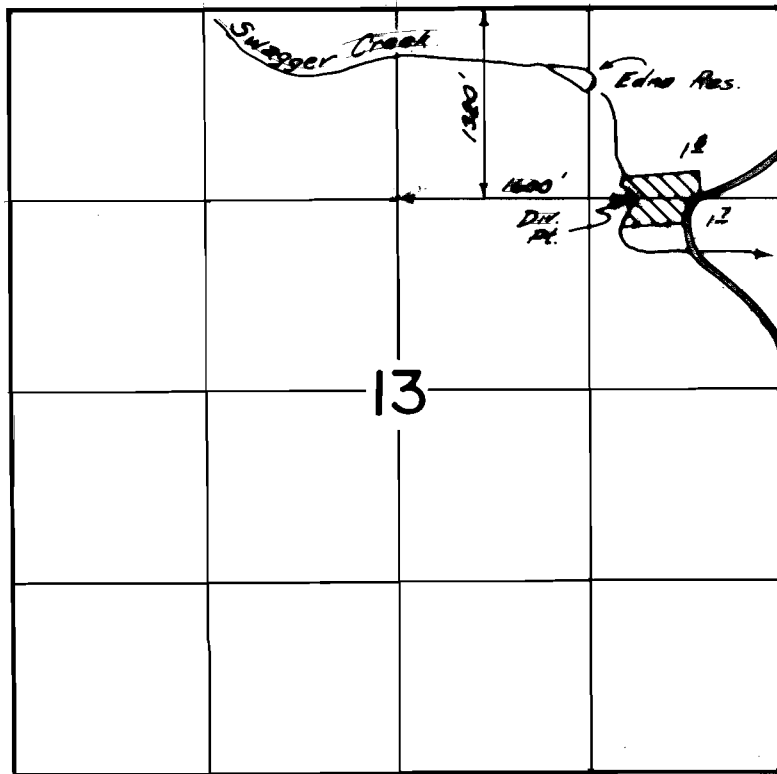

RESERVOIR: 500' S & 1350' E FROM N $\frac{1}{4}$  SEC 13

## FINAL PROOF SURVEY UNDER

R-54488                      R-6534  
Application No. 54489 Permit No. 40994

IN NAME OF

**HOWARD G. JACOBS**

Surveyed MAY 19, 1980, by *dl Brown*