


# T.4S.,R.3E.,W.M.

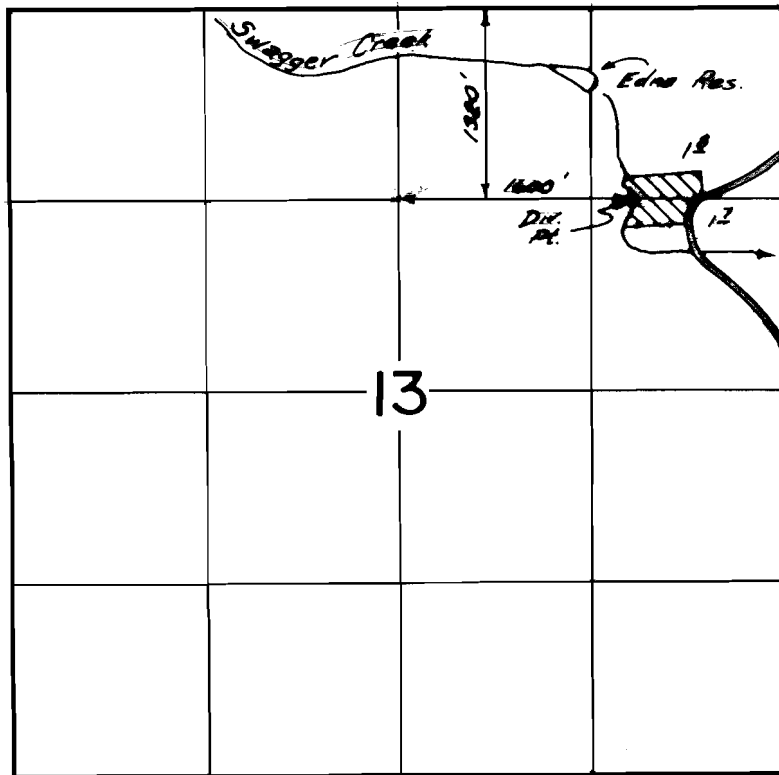

RESERVOIR: 500' S & 1350' E FROM N<sup>1</sup>/<sub>4</sub> SEC 13

## FINAL PROOF SURVEY UNDER

R-54488                      R-6534  
Application No. 54489      Permit No. 40994

IN NAME OF

**HOWARD G. JACOBS**

Surveyed MAY 19, 1980, by *Al Brown*