


T. 3N., R. 4W., W.M.

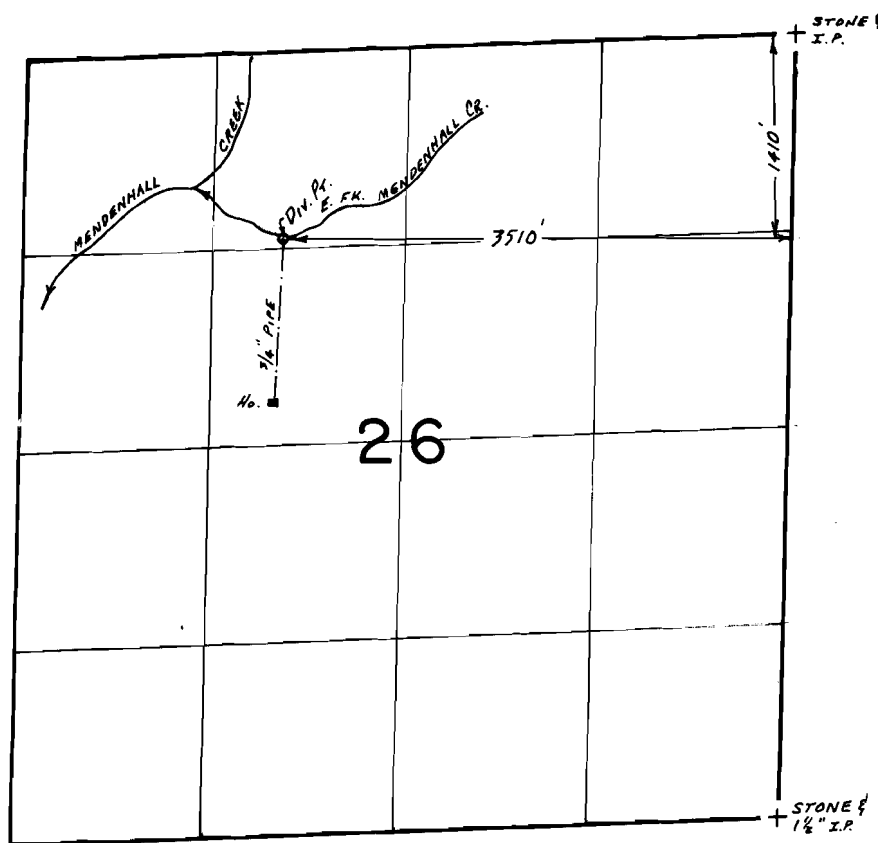

FINAL PROOF SURVEY
UNDER

Application No. 40767 Permit No. 30358
IN NAME OF

HOWARD L. & GENA S. GENTZKOW

Surveyed MAY 28 1980, by R.G. MUCKEN