


T.2S.R.5E.W.M.

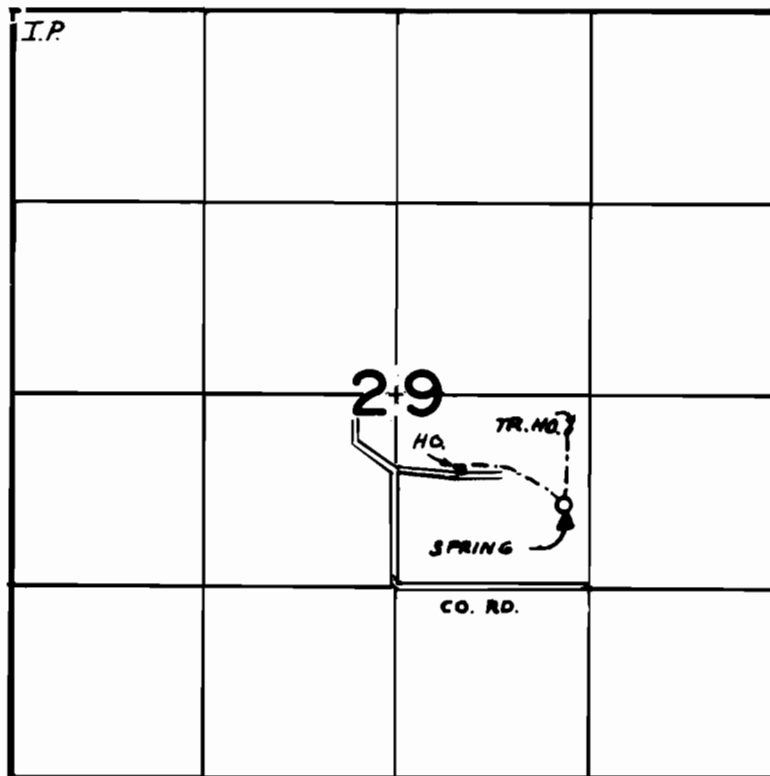

SPRING LOC.: 780' S. & 1150' E. FROM CEN. SEC. 29

FINAL PROOF SURVEY
UNDER

Application No. 47216 Permit No. 35369
IN NAME OF

M. J. REEDY

Surveyed MAY..10. 1979, by R.G.MUCKEN....