


T.3S.R.8W.W.M.

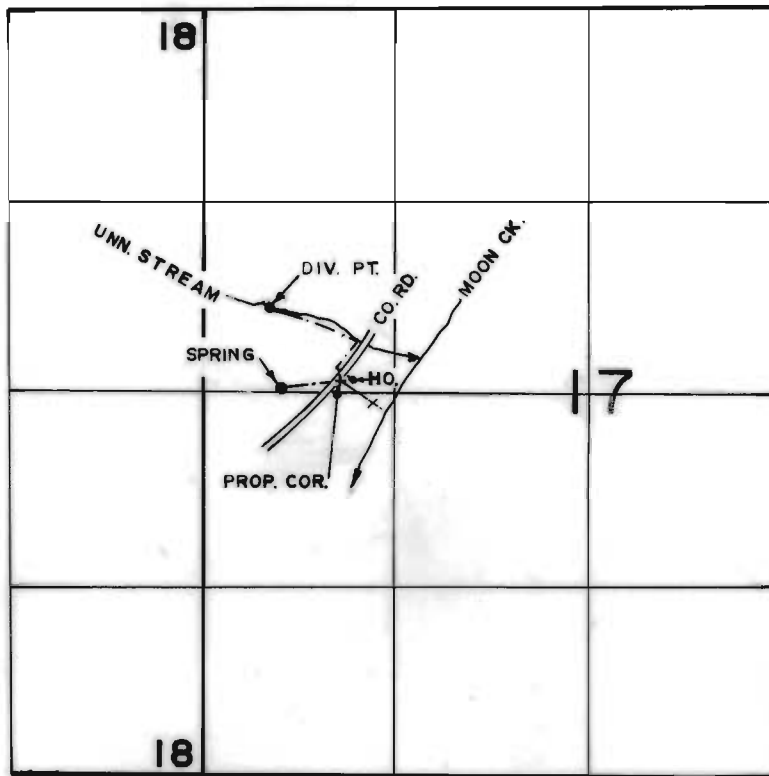

DIV. PT. LOC.: 580'N & 450'E., SPRING LOC.: 20'N & 520'E,
BOTH FROM W. 1/4 COR. SEC. 17

FINAL PROOF SURVEY UNDER

Application No. 52826.. Permit No. 37779.....
IN NAME OF

.....GLENN L. STOSE.....

Surveyed FEB 12... 19.80, by R.G. MUCKEN.....