


T. 18 & 19 S., R. 2 W., W.M.

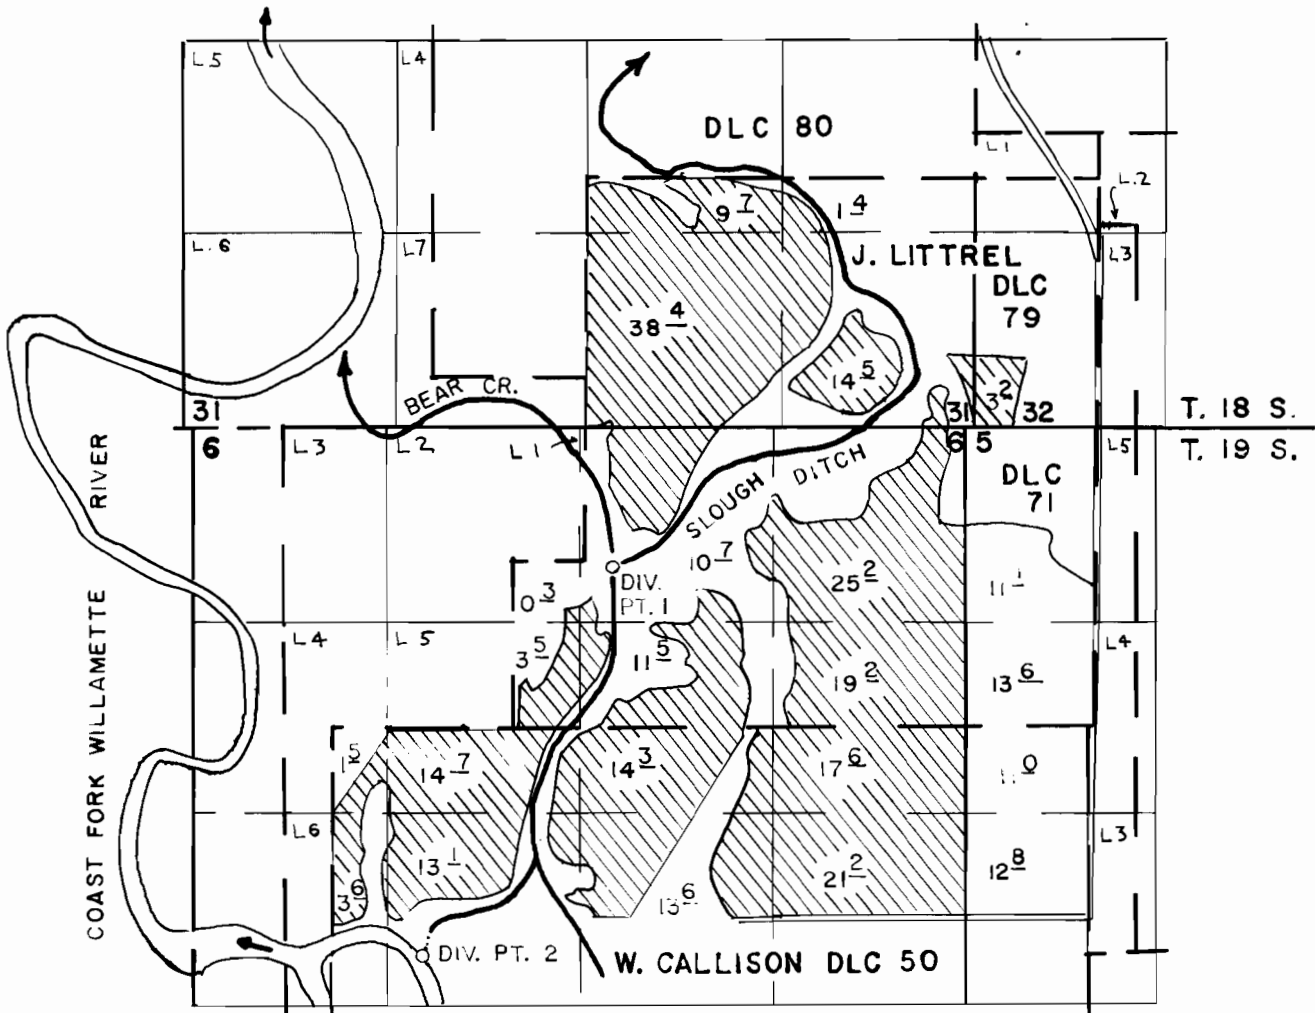

DIV. PT. 1 LOC. 1110' N. & 700' E.;
 PT. 2 LOC. 1550' S. & 630' W. Both from SW COR. DLC 71.

FINAL PROOF SURVEY UNDER

Application No. 52023 Permit No. 38199
 IN NAME OF

LARRY J. & CORRIN M. SCHRENK

Surveyed AUG 27, 1984, by P. PAGTER



SCALE
 1" = 1320'