


T. 9 S., R. 10 W., W.M.

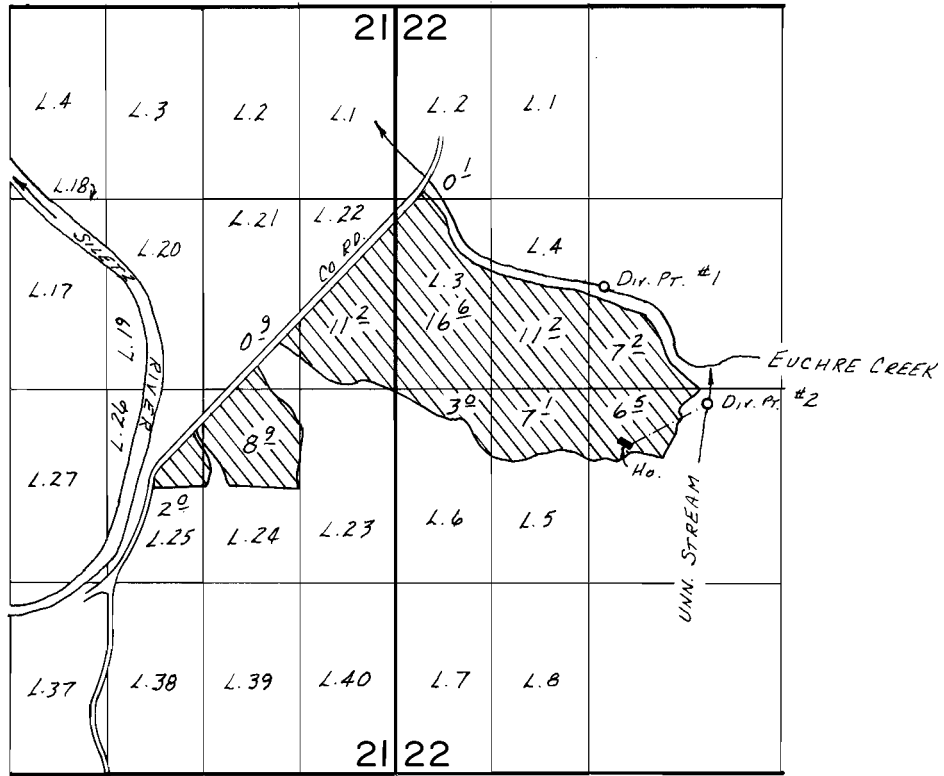

Div. Pts. Loc.: #1- 1930'S. § 1440'E., #2- 2740'S. § 2140'E., BOTH FROM NW COR. SEC. 22.

SCALE: 1"=1320'

**FINAL PROOF SURVEY**  
UNDER

Application No. 50625... Permit No. 38255.....  
IN NAME OF

.....JAMES E. & NEDRA M. JOHAN.....

Surveyed .Sept. 11... 19.84, by B.W. BISHOP.....