

T. 1S., R. 45E., W.M.

27




SCALE 1" = 1320'


T. 3S., R. 45E., W.M.

33

34

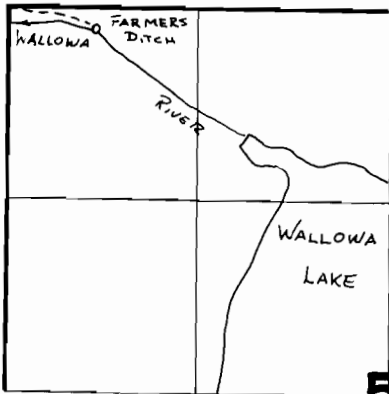

Div. Pt. LOCATED 250' S. AND 600' E. FROM N.W. COR. SEC. 5 PER. 38944

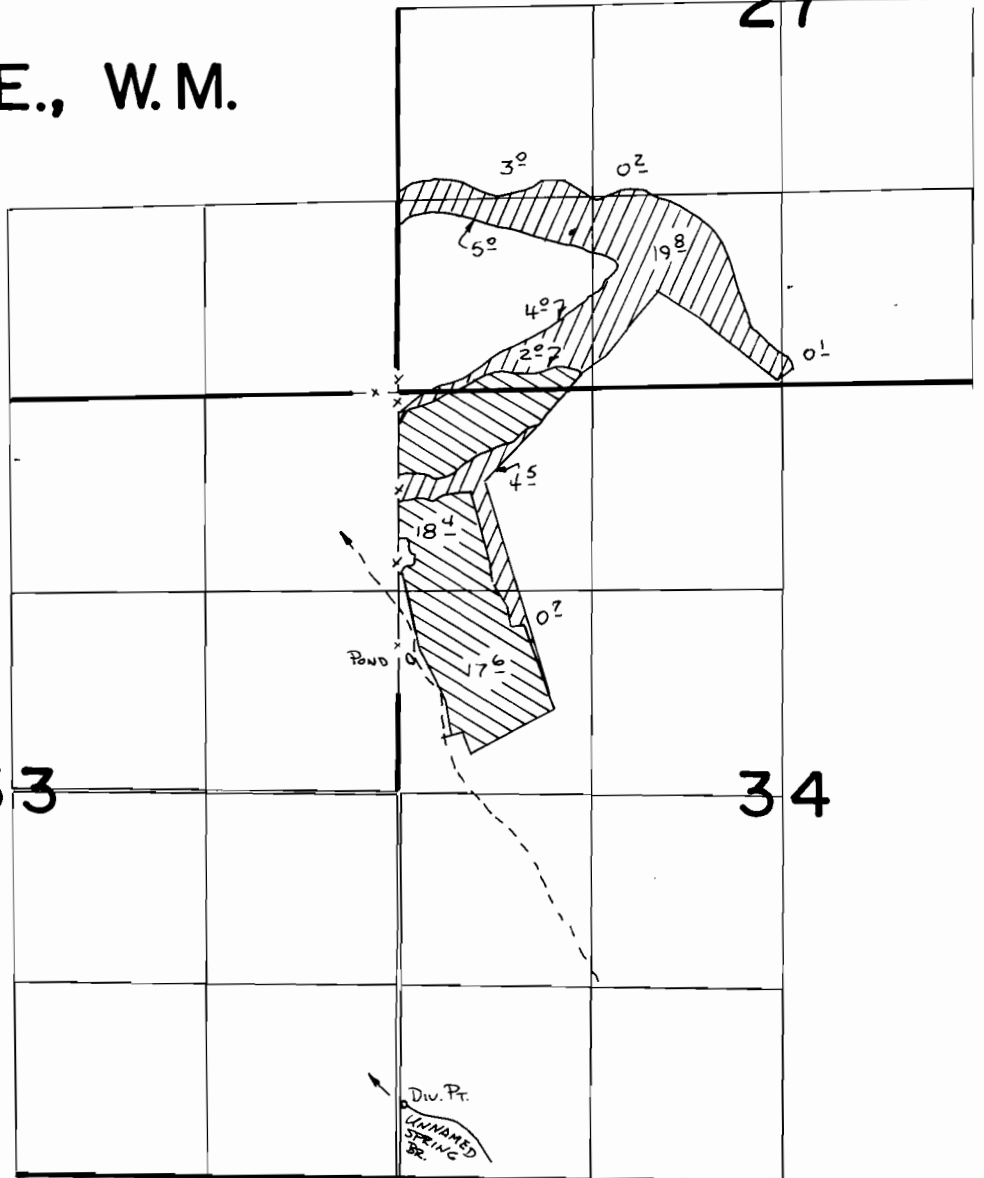

Div. Pt. LOCATED 510' N. & 50' E. FROM SW. COR. SEC. 34, PER. 41527

PRIM. PER: 38944

SUPPL. PER: 41527

FINAL PROOF SURVEY UNDER

51647

38944

Application No. 55421 Permit No. 41527.....

IN NAME OF

KENNETH C. HOUGH

Surveyed 8-9..... 1984.., by V.L. Church.....