


T. 1S., R. 45E., W.M.

27

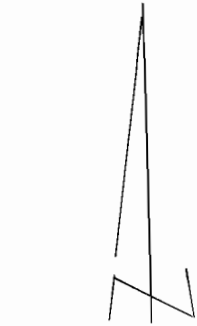


SCALE 1" = 1320'


T. 3S., R. 45E., W.M.

33

34

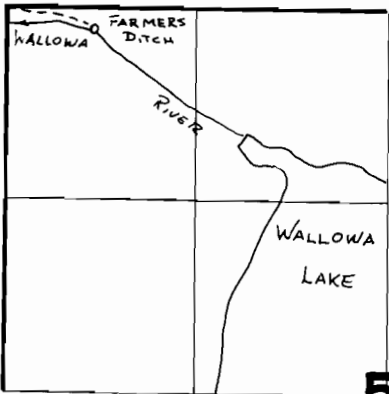

Div. Pt. LOCATED 250' S. AND 600' E. FROM N.W. COR. SEC. 5 PER. 38944

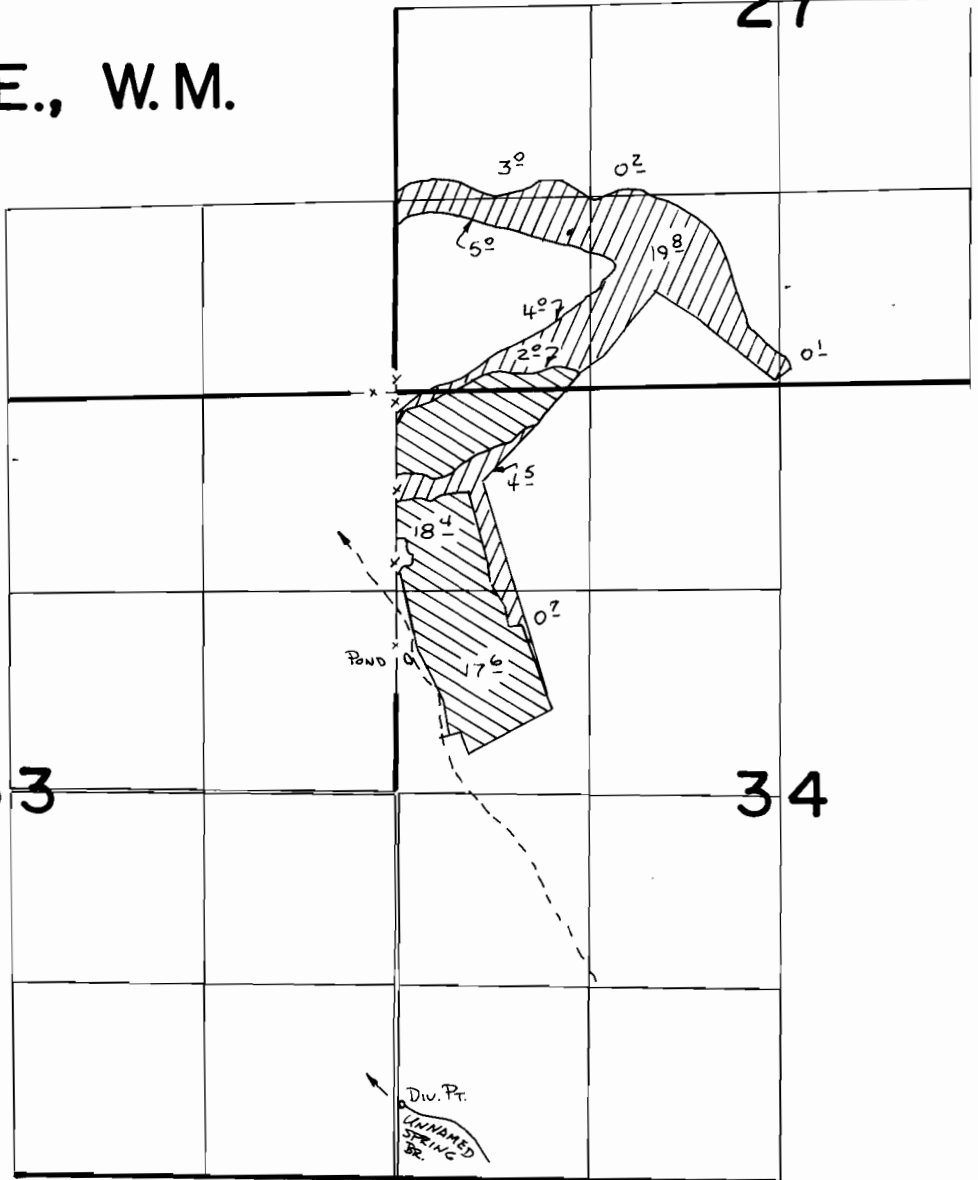

DIV. PT. LOCATED 510' N. & 50' E. FROM SW. COR. SEC. 34, PER. 41527

PRIM PER: 38944

SUPP'L PER: 41527

### FINAL PROOF SURVEY UNDER

Application No. **51647** Permit No. **38944**  
**55421** Permit No. **41527**  
IN NAME OF

**KENNETH C. HOUGH**

Surveyed 8-9 1984, by V.L. Church