


T.16&17S. R.5W.W.M.

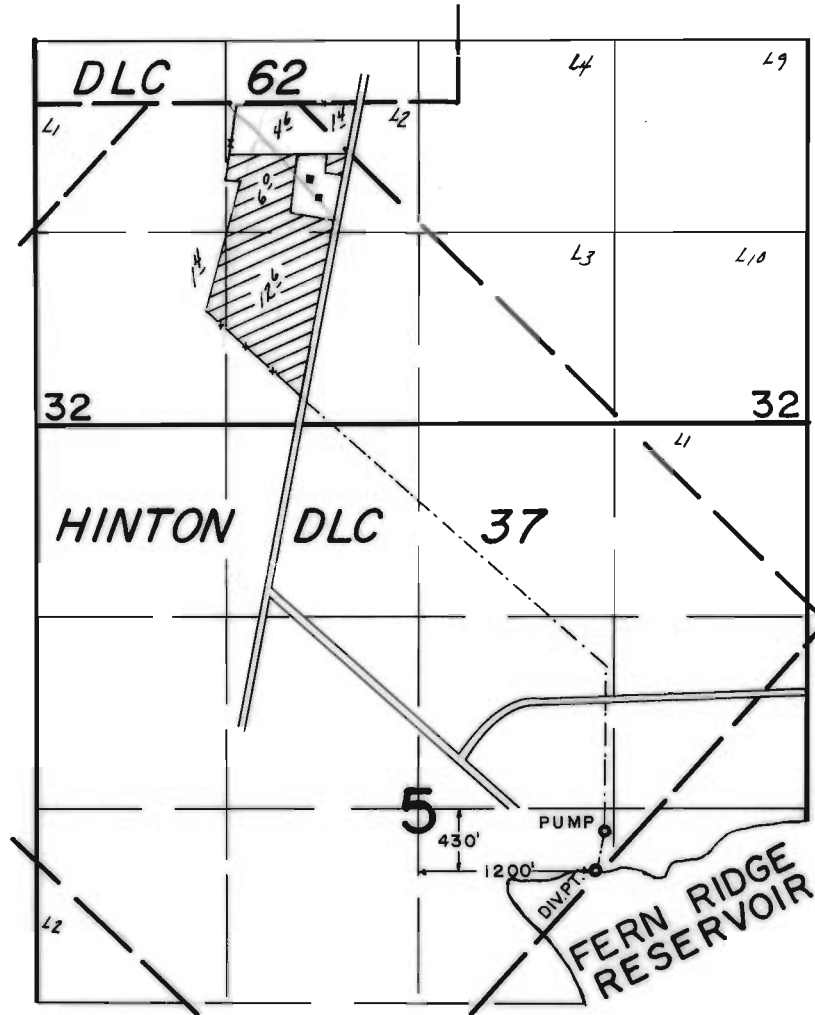

FINAL PROOF SURVEY
UNDER

Application No. 51681.... Permit No. 38967....
IN NAME OF

CLARENCE & ALICE RUTHERFORD

Surveyed May...15... 1979., by S.C.BROWN.....