


T.16&17S.R.5W. W. M.

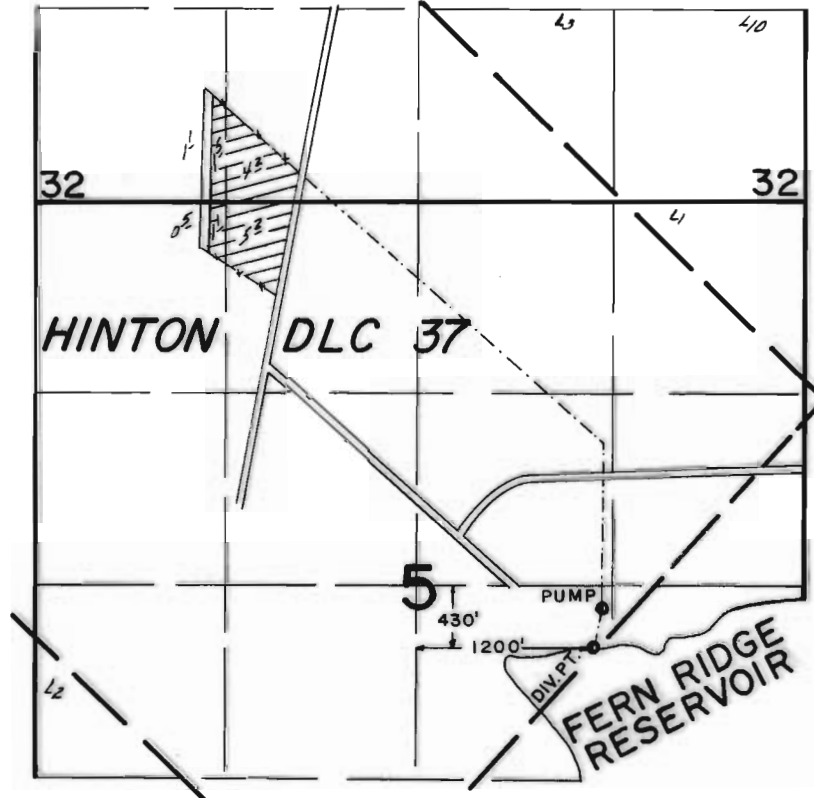

FINAL PROOF SURVEY
UNDER

Application No. 51682... Permit No. 38968.....
IN NAME OF

EMIL & WINIFRED J. THEOPHANES

Surveyed May...15... 1979., by S.C.BROWN.....