T. 6S., R. 1W., W.M.

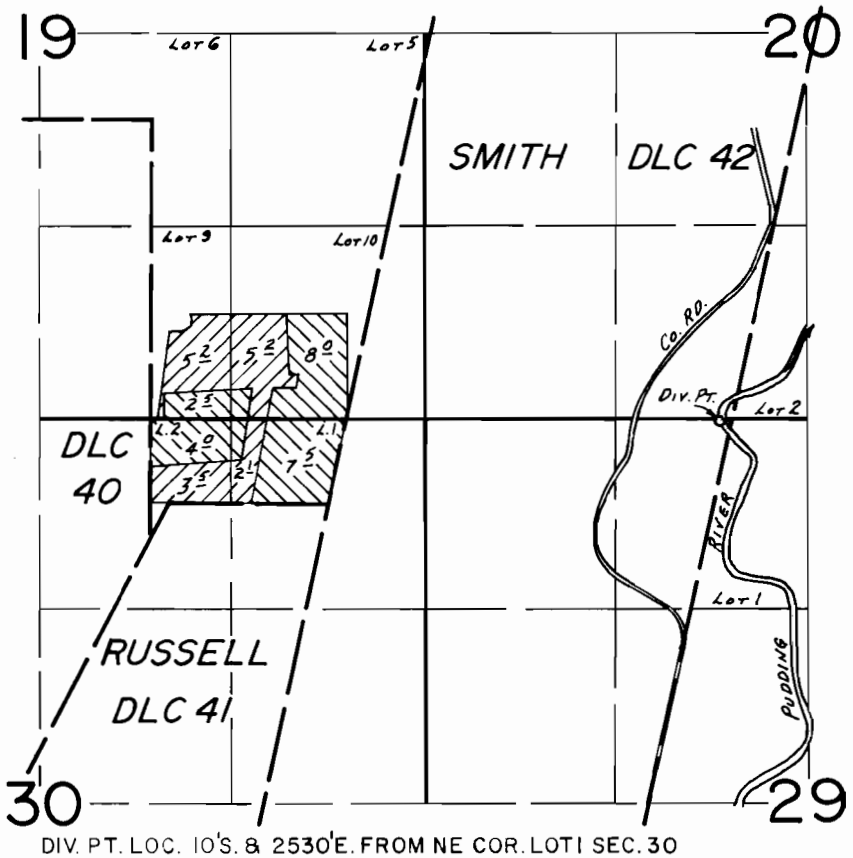

DIV. PT. LOC. 10'S. & 2530'E. FROM NE COR. LOT 1 SEC. 30

FINAL PROOF SURVEY

UNDER

Application No. 51870 Permit No. 39044

IN NAME OF

ROBERT VACHTER

Surveyed MAY 13 19 80, by B.W. BISHOP

DFN-1LL-37