


T.17S.,R.7W.,W.M.

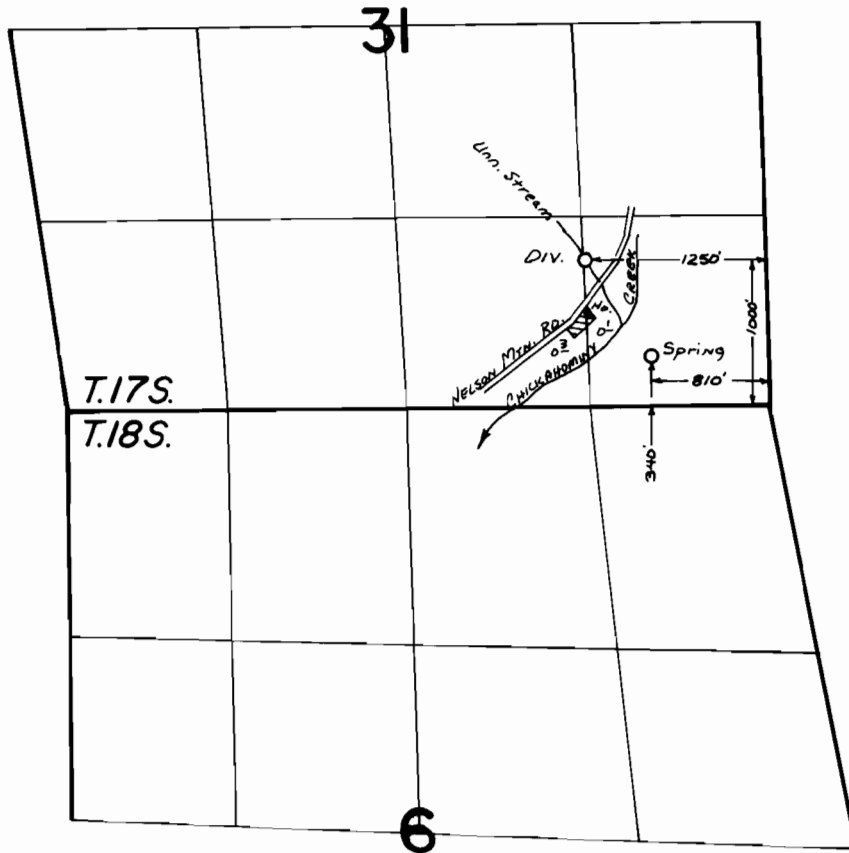

FINAL PROOF SURVEY
UNDER

Application No. 51859... Permit No. 39148.....

IN NAME OF

RICHARD &
.....THERESA FRIZZELL.....

Surveyed Aug...4.... 1982., by L.M. IOLL.....