
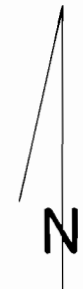


T.20S., R.2W., W.M.

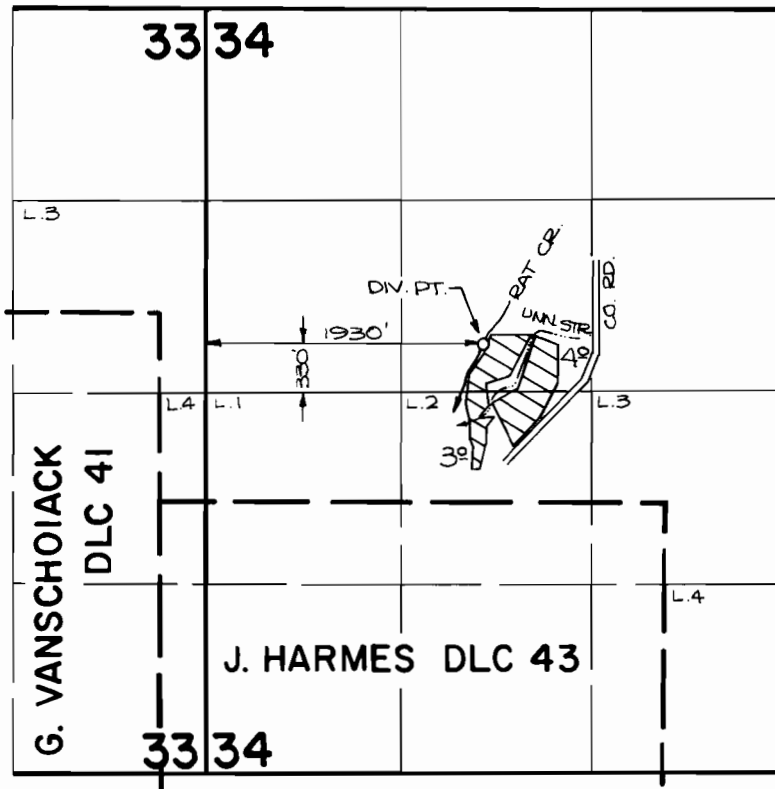

SCALE: 4" = 1 MILE

FINAL PROOF SURVEY
UNDER

Application No. 52030.. Permit No. 39214.....
IN NAME OF

.....**MAE C. DOOLITTLE**.....

Surveyed SEPT. 26, 1984, by P. Patten.....