


T. 36 S., R. 4 W., W.M.

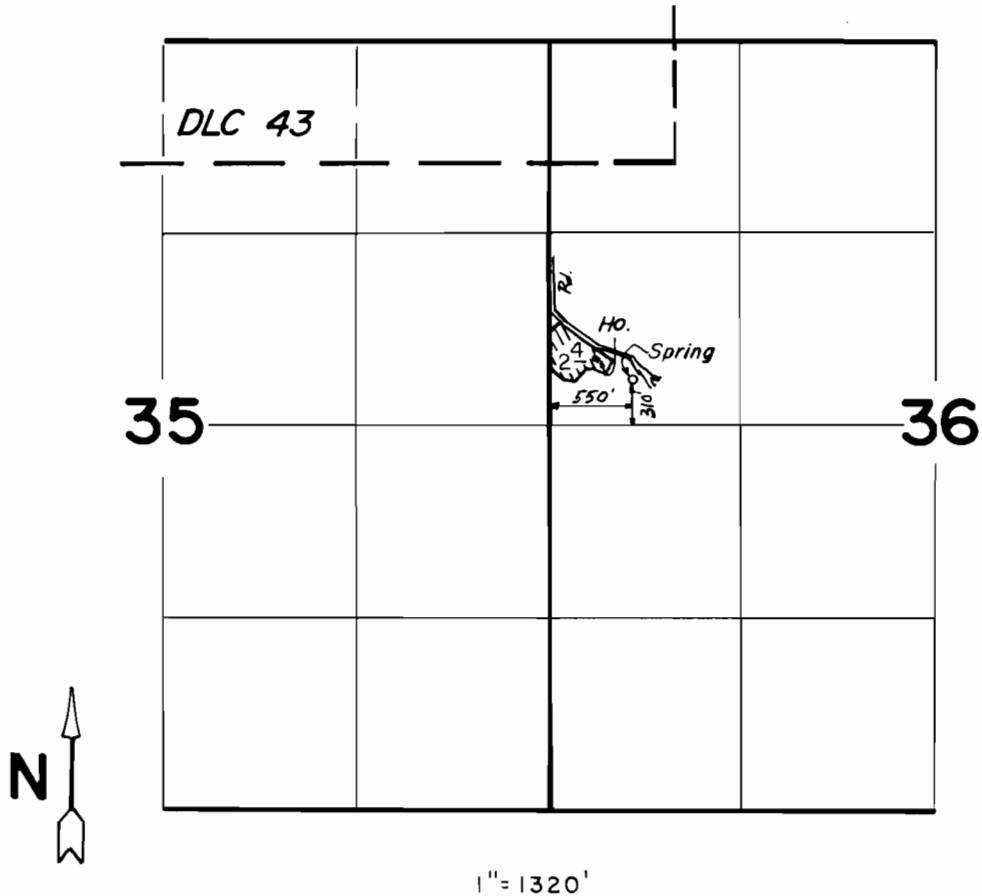

FINAL PROOF SURVEY
UNDER

Application No. 52111..... Permit No. 39256.....
IN NAME OF

GEORGE B. VINSON

Surveyed APRIL 12, 1983, by B. S. JAMES.....