


# T.38S., R.8W., W.M.

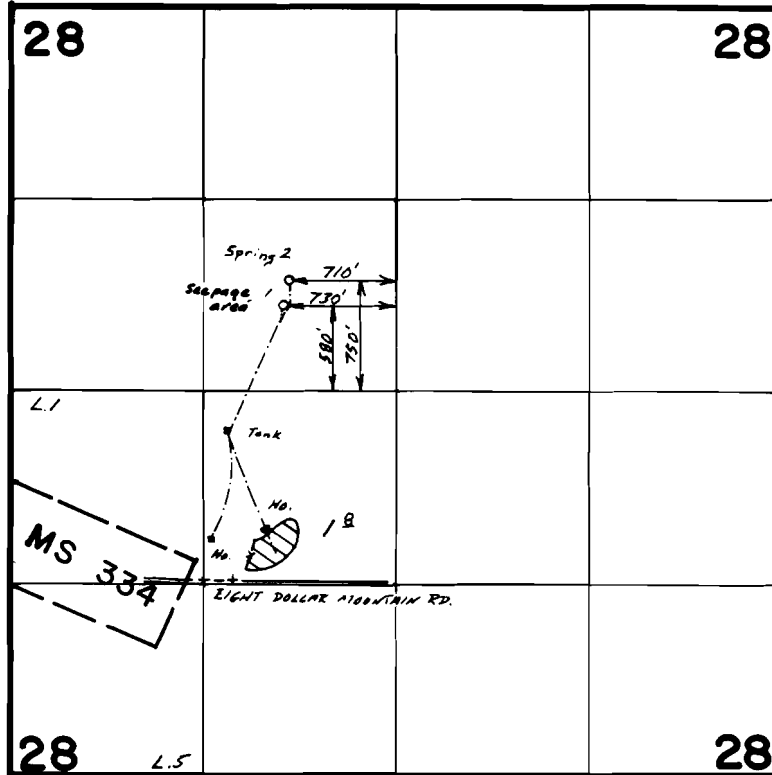

Scale 1"=1320'

## FINAL PROOF SURVEY UNDER

Application No. 52209.. Permit No. 39306.....  
IN NAME OF

Ronald E. Brood & Estate of T.E. Markam

Surveyed June 9, 1986, by B.S. JAMES.....