


T.3S., R.4 & 5W., W.M.

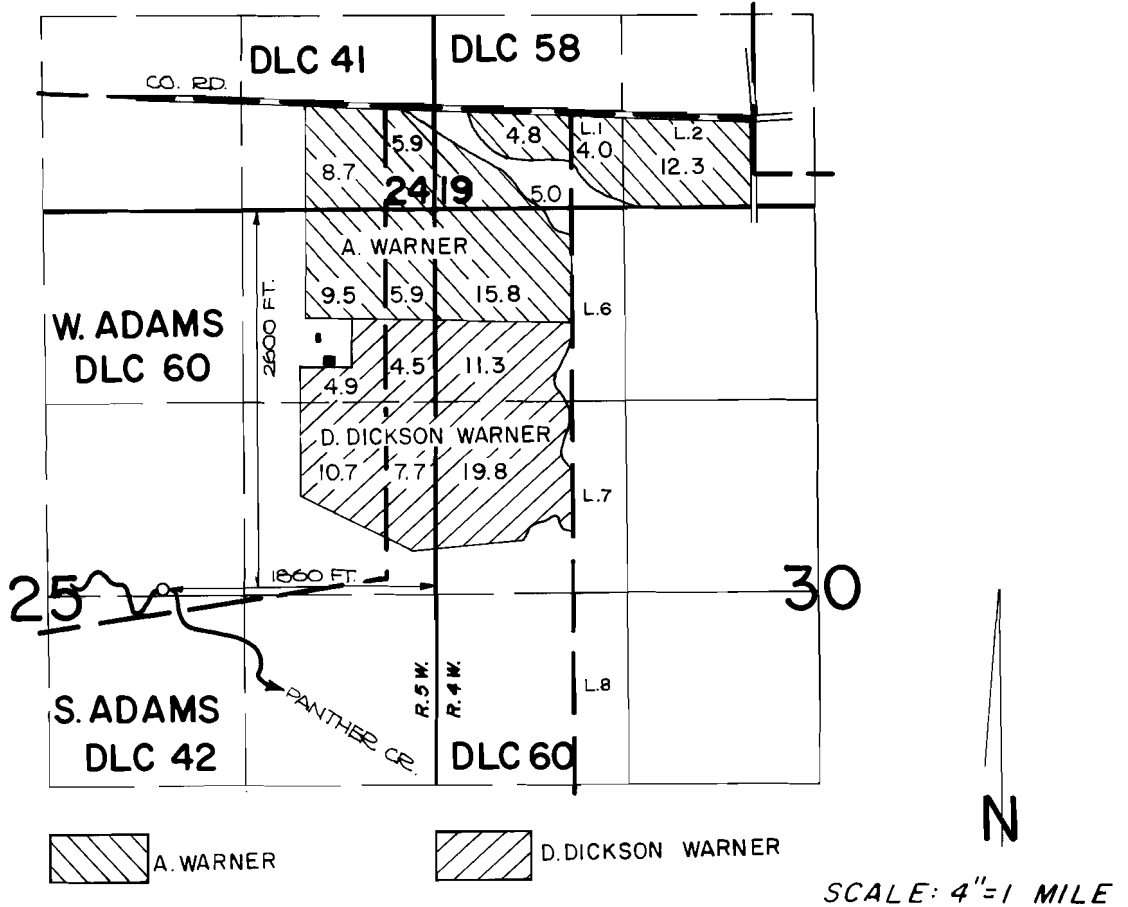

FINAL PROOF SURVEY UNDER

Application No. 53437.. Permit No. 39762.....
IN NAME OF

AUSTIN C. WARNER & DAPHNE DICKSON WARNER

Surveyed JULY 10, 1984, by *P. Pagten*