


T.4N.R.8W.W.M.

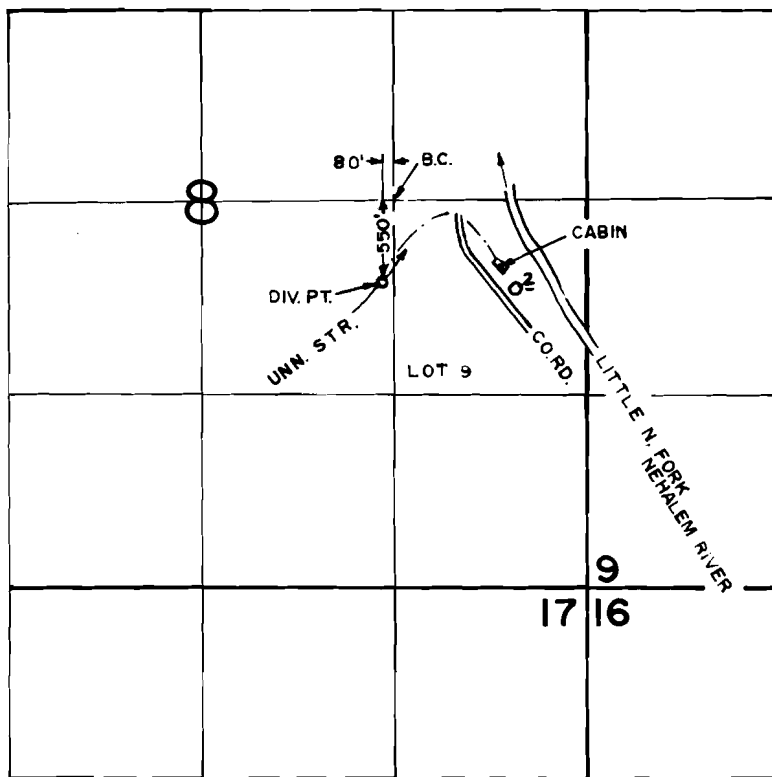

FINAL PROOF SURVEY UNDER

Application No. 54136.. Permit No. 40527.....
IN NAME OF

.....SETH M. BELLWOOD JR......

Surveyed FEB. 20. 1980., by R.G. MUCKEN.....