


T.7S., R.1E., W.M.

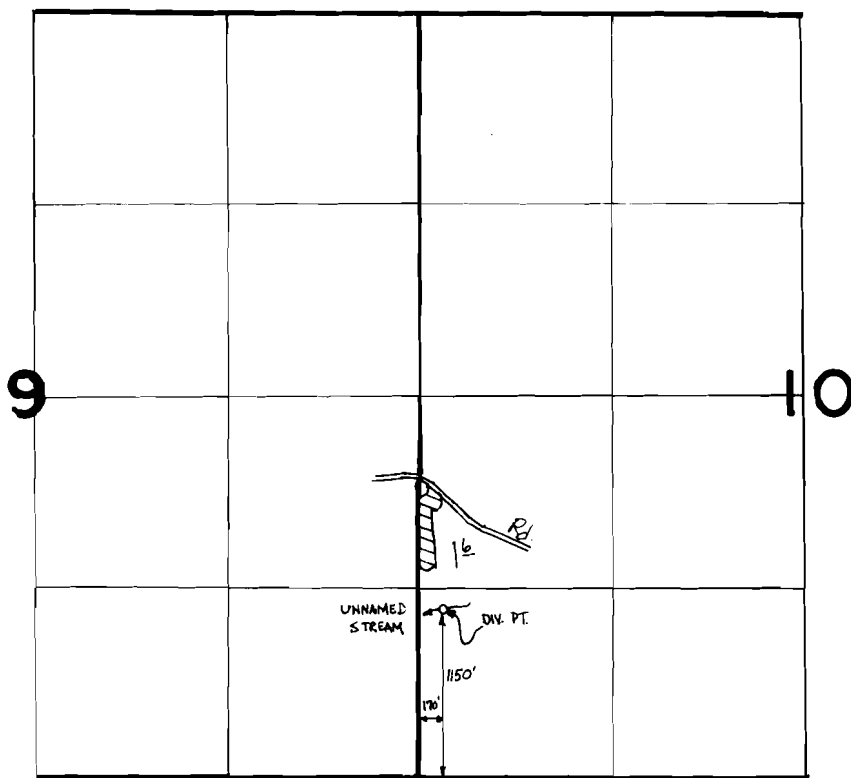

FINAL PROOF SURVEY UNDER

Application No. **54662** Permit No. **41011**.....
IN NAME OF

SUSAN A. HEISE.....

Surveyed **NOV. 15**, 19**83**, by **M. CAHILL**.....