


T.2N.R.3W.W.M.

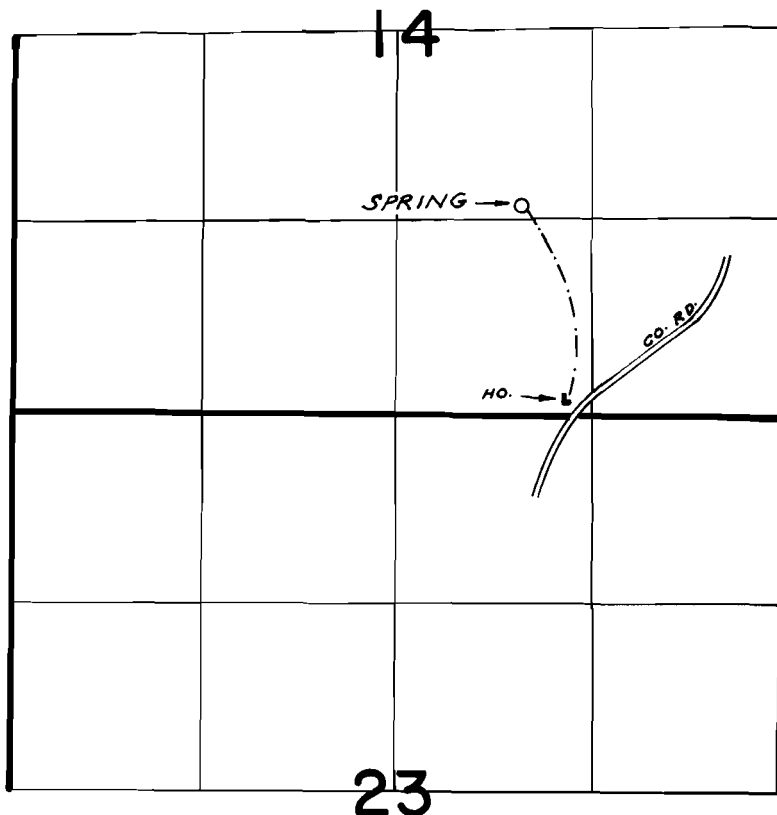

SPRING LOC: 1440' N. & 1820' W. FROM S.E. COR. SEC. 14

FINAL PROOF SURVEY
UNDER

Application No. 54680 Permit No. 41026
IN NAME OF

DAVID B. EDWARDS, JR.

Surveyed MAY 30 1980, by R. MUCKEN