


T.16S., R.5W., W.M.

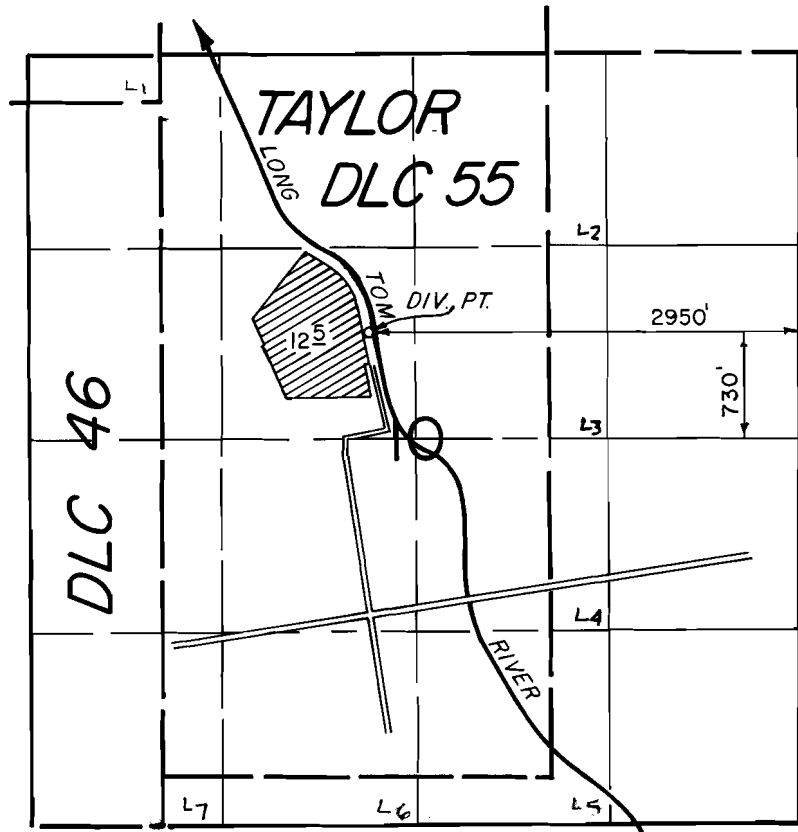

FINAL PROOF SURVEY
UNDER

Application No. 55841 Permit No. 41894
IN NAME OF

NEIL D. CHESHIRE

Surveyed MAY 7, 1980, by *[Signature]*