


T.19S.,R.1W.,W.M.

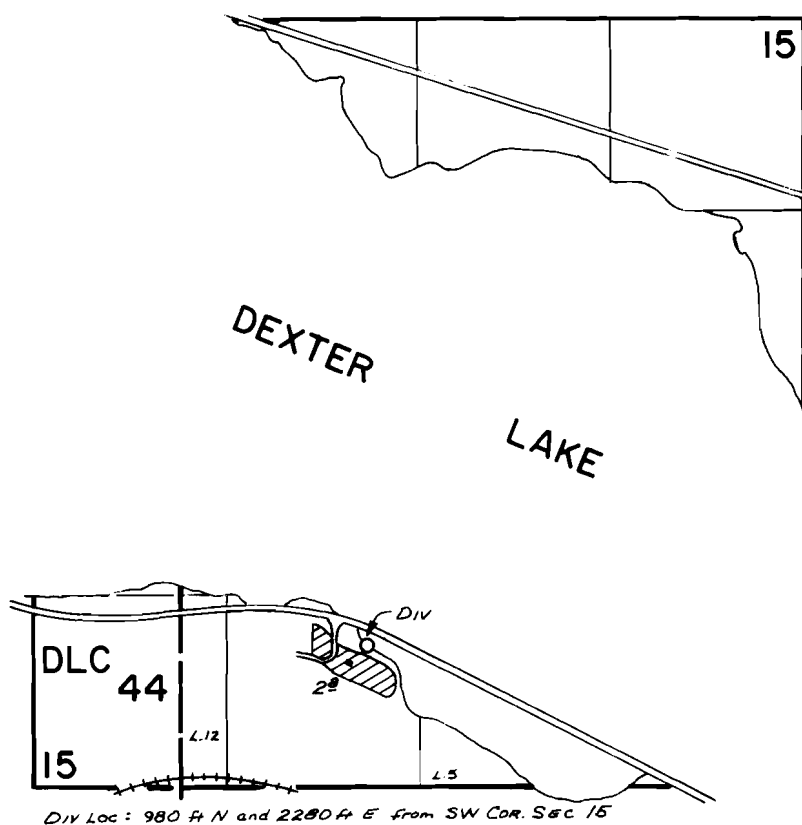

FINAL PROOF SURVEY

UNDER

Application No. 57279..... Permit No. 43086.....
IN NAME OF

VIOLA G. PHELPS.

Surveyed Sept. 15, 1981, by S. C. BROWN