


# T. 33 S., & T. 34 S., R. 5 W., W.M.

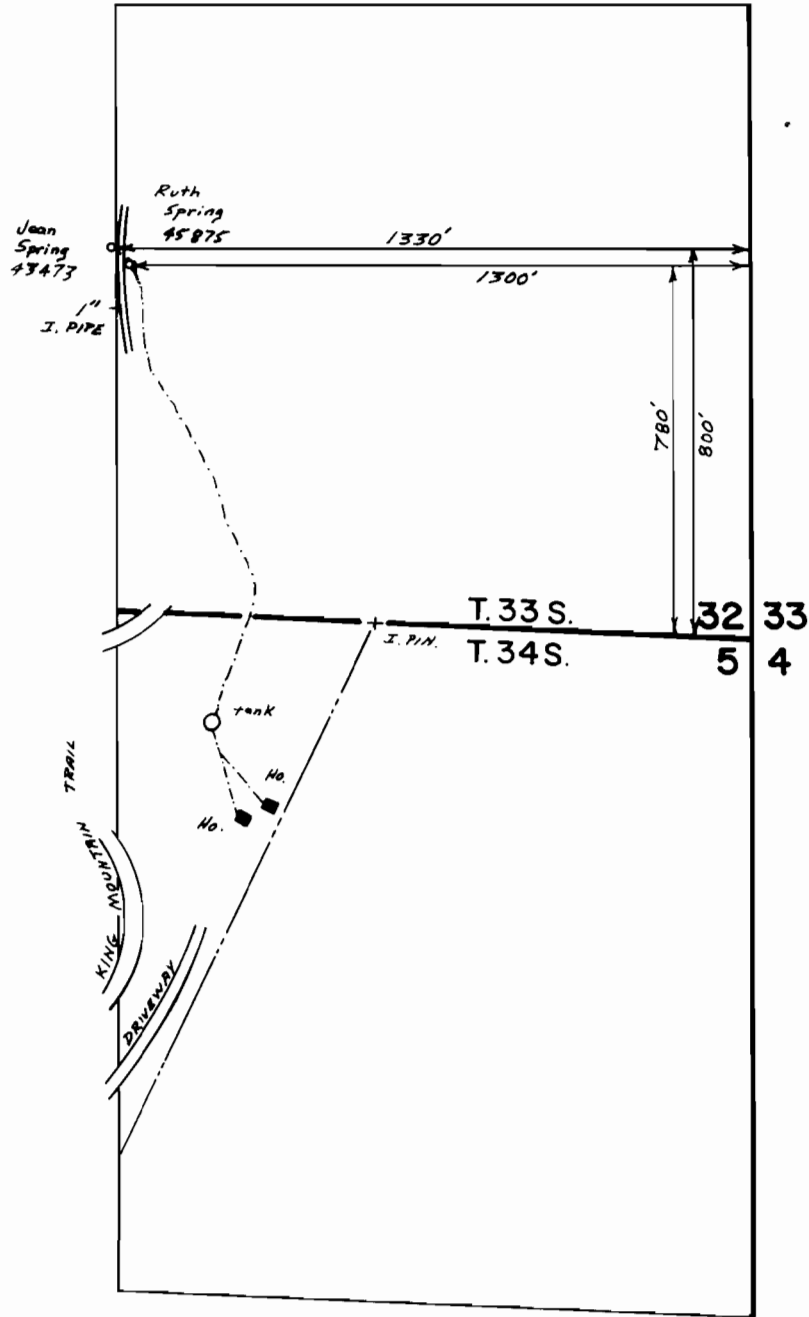

## FINAL PROOF SURVEY UNDER

57765                      43473  
 Application No. 61634... Permit No. 45875...  
 IN NAME OF

JEAN & RUTH MOUNTAINGROVE

Surveyed Aug. 28, 1986, by B.S. JAMES