


T. 33 S., & T. 34 S., R. 5 W., W.M.

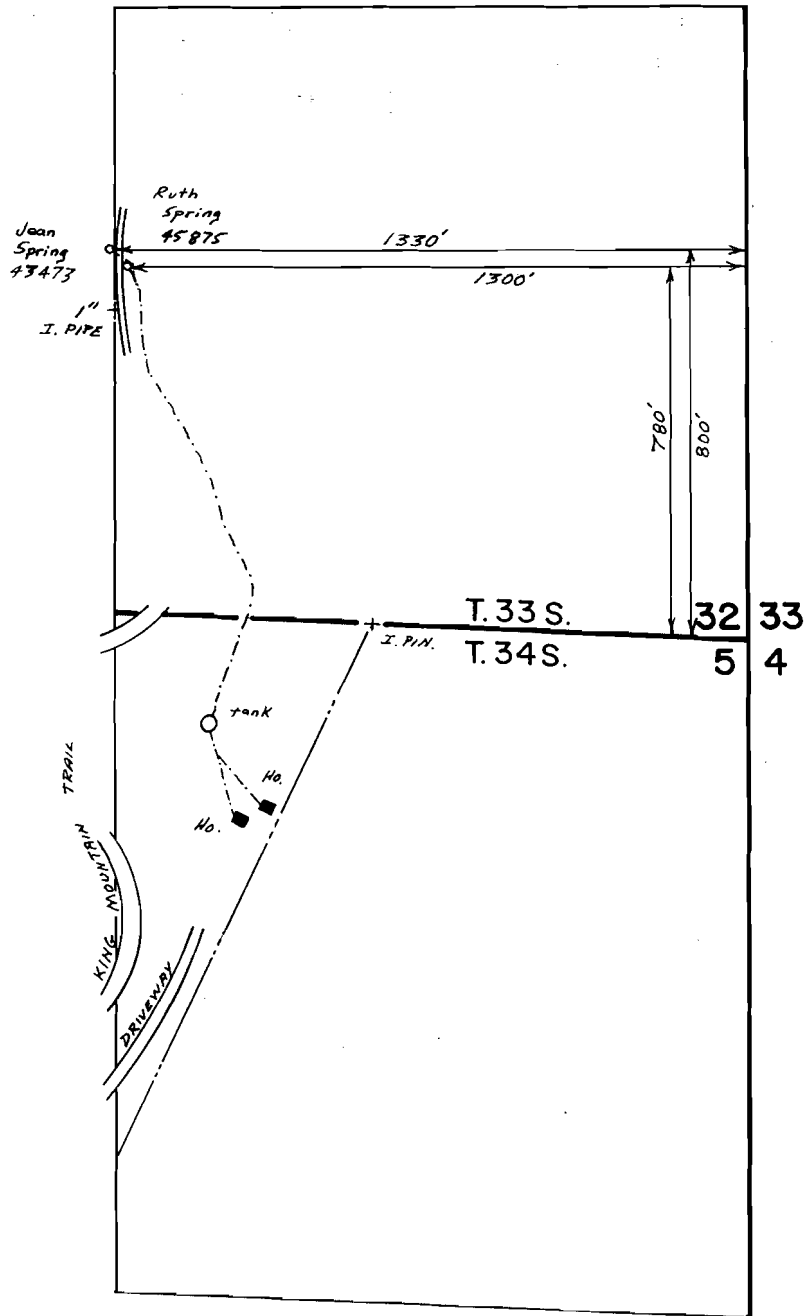

Scale 1" = 400'

FINAL PROOF SURVEY UNDER

57765 43473
 Application No. 61634 Permit No. 45875
 IN NAME OF

JEAN & RUTH MOUNTAINGROVE

Surveyed Aug. 28, 1986, by B.S. JAMES