


T.37S., R.7W., W.M.

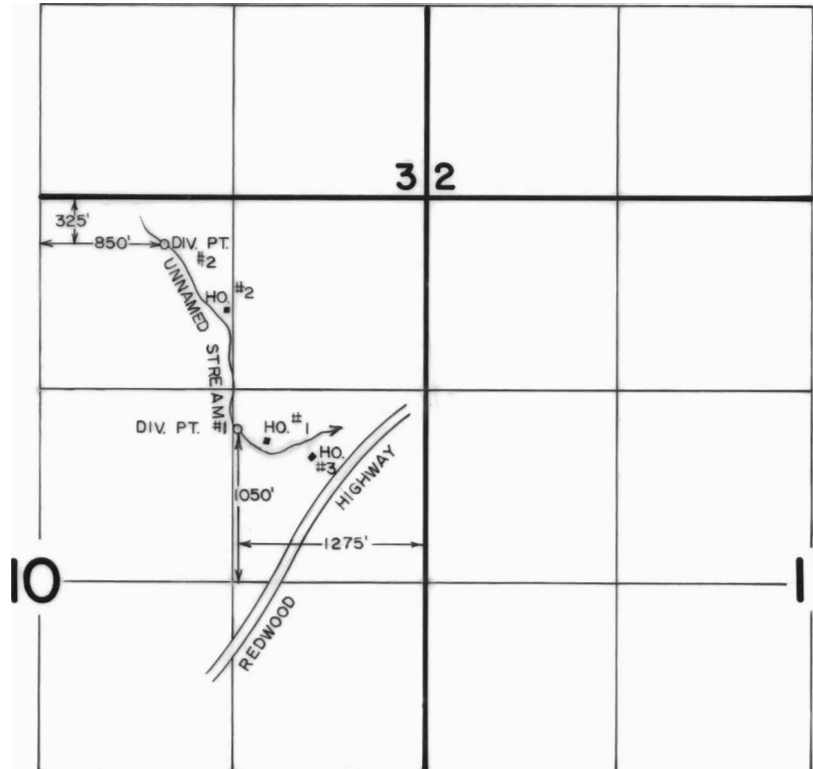

FINAL PROOF SURVEY
UNDER

Application No. 58316 Permit No. 44014
IN NAME OF

GARY MORGAN & HARVEY MORGAN

Surveyed OCT. 24 1983, by B. S. JAMES

SCALE: 4" = 1 MILE