T. 32 S. R.6 W. W.M.

N.E. 1/4 of S.E. 1/4 of Section 33

SCALE: 1" = 400'

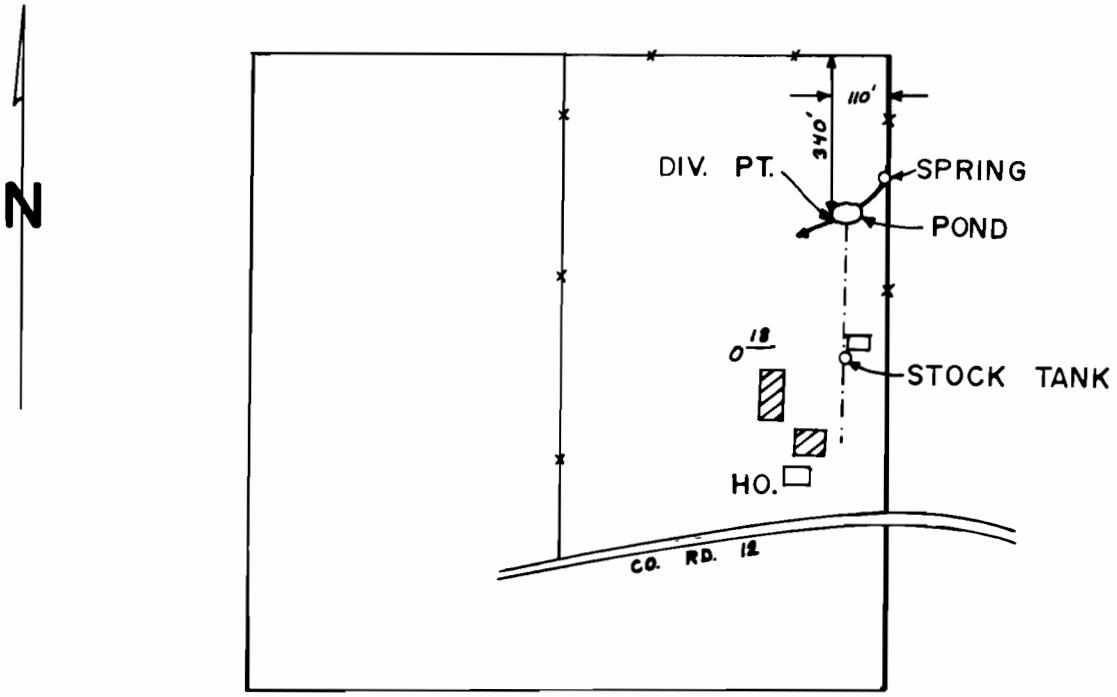

FINAL PROOF SURVEY

UNDER

Application No. 58115 Permit No. 44017

IN NAME OF

HAROLD R. and K. MABLE STAPLETON

Surveyed NOV. 29 1983, by L. E. Cashion

41019-278 123 A LEC