


T. 3 N., R. 10 W., W.M.

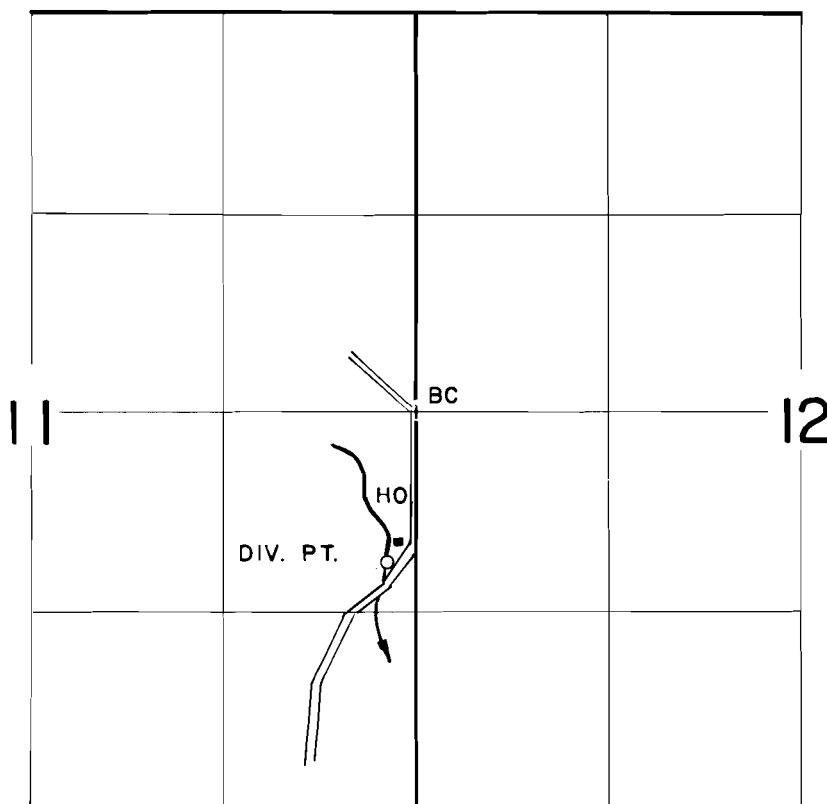

DIV. PT. LOC. 1040' S & 210' W. OF E 1/4 COR. SEC. 11

FINAL PROOF SURVEY UNDER

Application No. 58370 Permit No. 44087
IN NAME OF

GARY LEWIS DEY

Surveyed MAY 22, 1984, by P. PAGTER