


T.33S.,R.5W.,W.M.

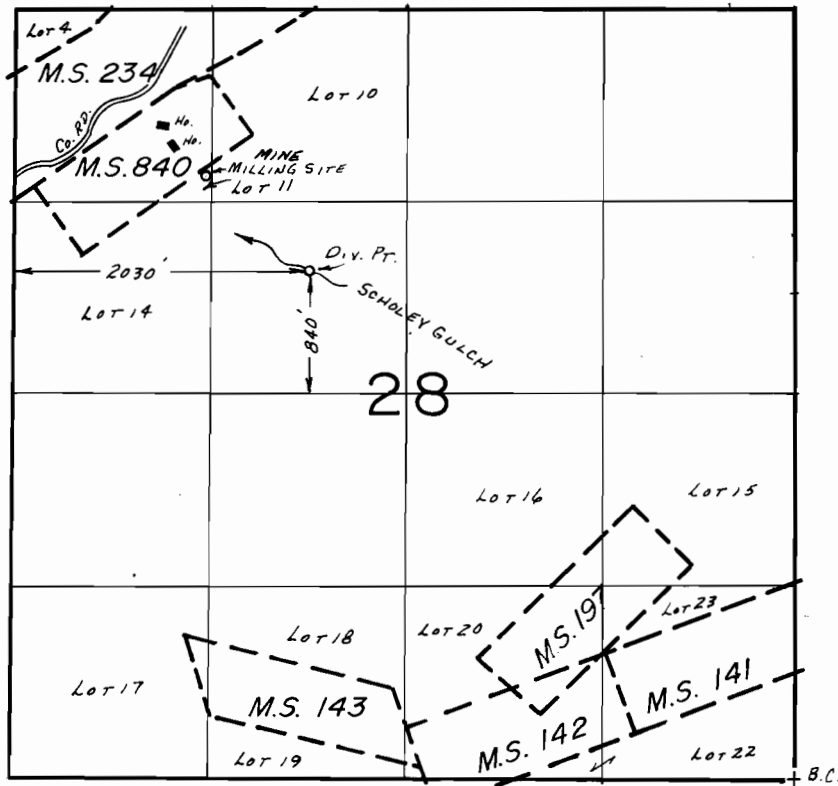

SCALE: 1" = 1320'

FINAL PROOF SURVEY
UNDER

Application No. 59310... Permit No. 44629.....
IN NAME OF

.....JOHN H. MILLER.....

Surveyed Sept. 25.. 19.84, by J.R. WOODROOF.