


T. 3 N., R. 10 W., W.M.

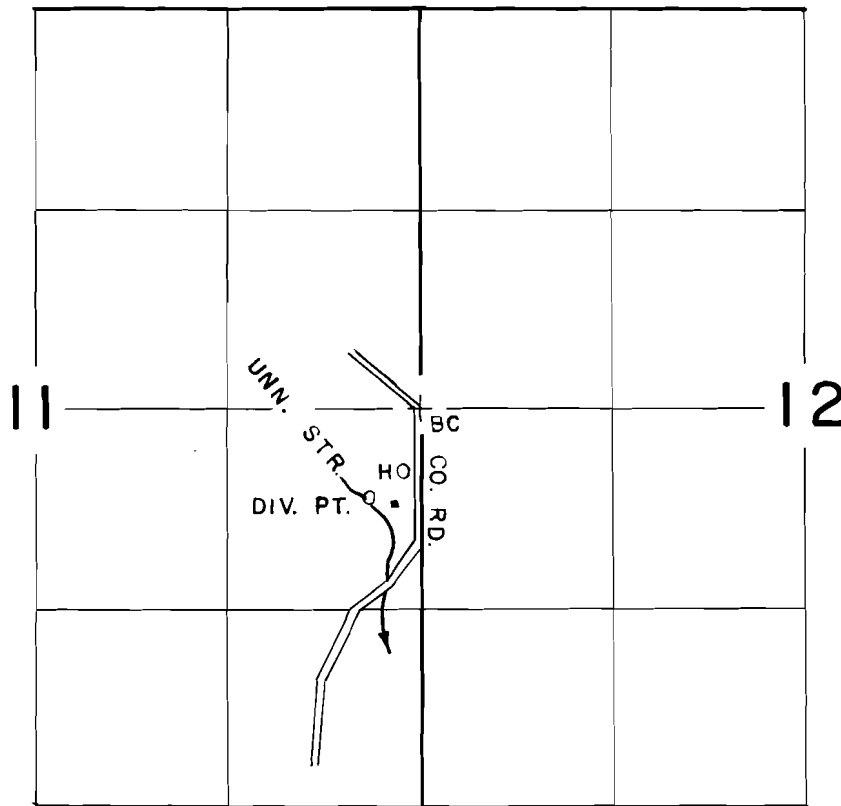

SCALE
1" = 1320'

DIV. PT. LOC. 610' S & 370' W OF E 1/4 COR. SEC 11

FINAL PROOF SURVEY UNDER

Application No. 60106 Permit No. 44875
IN NAME OF

BETTY C. & LARRY R. ELLIS

Surveyed MAY 22 1984, by P. PAGTER