


T. 40 S., R. 9 W., W. M.

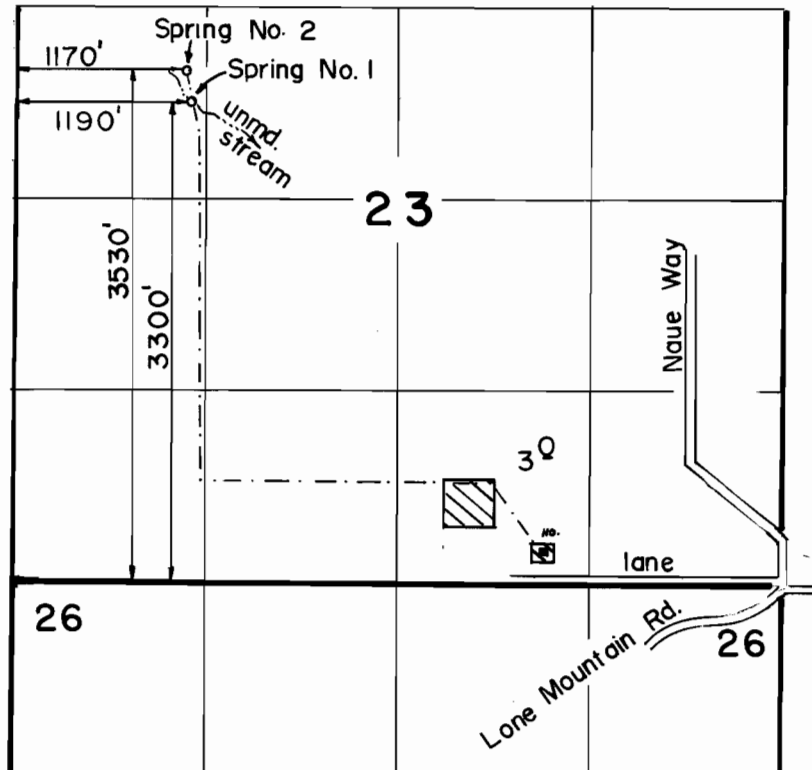

Scale: 1" = 1320'

FINAL PROOF SURVEY

UNDER

59837 45226
Application No. 63070 Permit No. 46913
IN NAME OF

DIXON DAVIS

Surveyed APR. 16. 1986, by B. S. JAMES.