
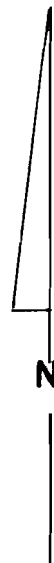


T. 3 N., R. 10 W., W.M.

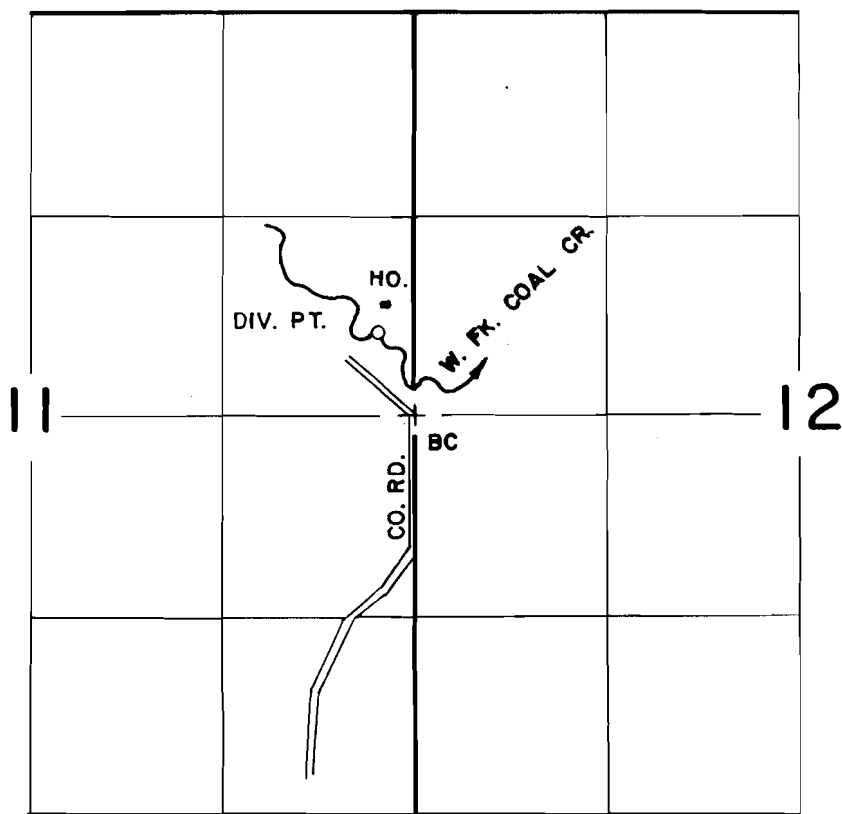

SCALE

1" = 1320'

DIV. PT. LOC. 580' N & 250' W OF E 1/4 COR. SEC. 11

FINAL PROOF SURVEY UNDER

Application No. 60916 Permit No. 45424
IN NAME OF

RICHARD W. HAWARD

Surveyed MAY 22, 1984, by P. PAGTER