


T. 3 N., R. 10 W., W. M.

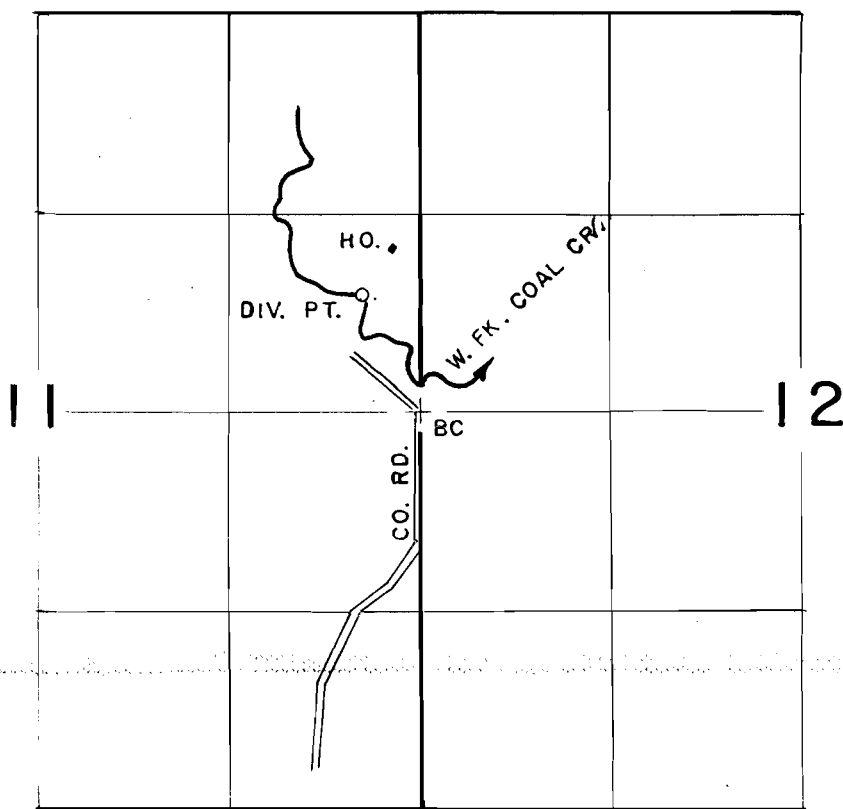

SCALE
1" = 1320'

DIV. PT. LOC. 800' N & 400' W. OF E. 1/4 COR. SEC. 11

FINAL PROOF SURVEY UNDER

Application No. 60822... Permit No. 45503...
IN NAME OF

WAYNE MICHAEL & VELDA DEY CURTIS

Surveyed MAY 22 1984, by P. PAGTER...