


T. 34 S., R. 5 W., W. M.

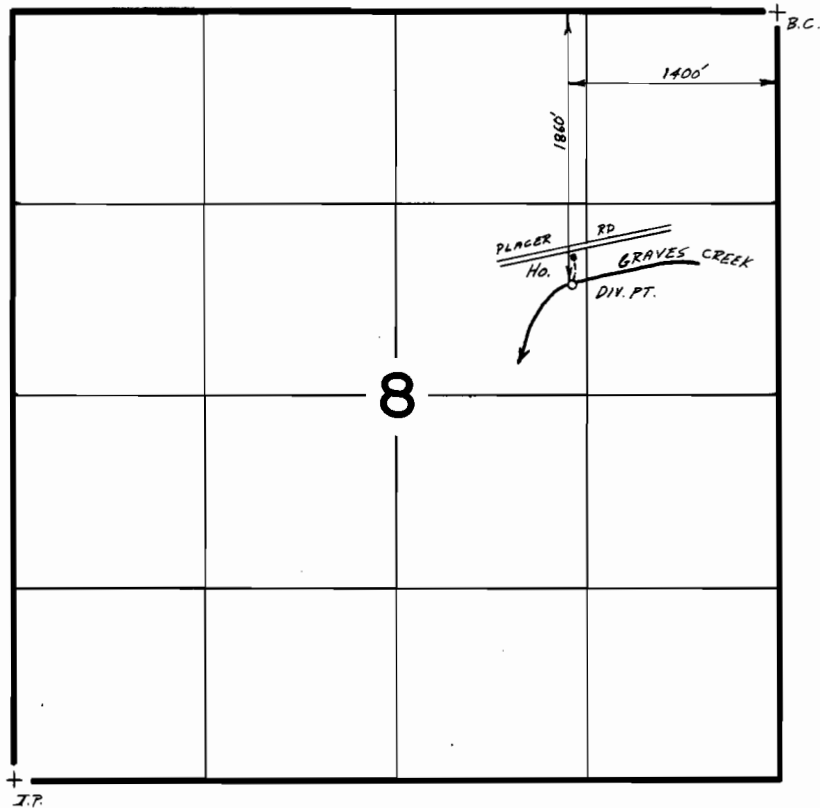

Scale 1"=1320'

FINAL PROOF SURVEY UNDER

Application No. 65165... Permit No. 47835...
IN NAME OF

.....RICHARD D. PANKEY.....

Surveyed Aug. 13. 19 86, by B.S. JAMES.....