


T36S, R4W, W.M.

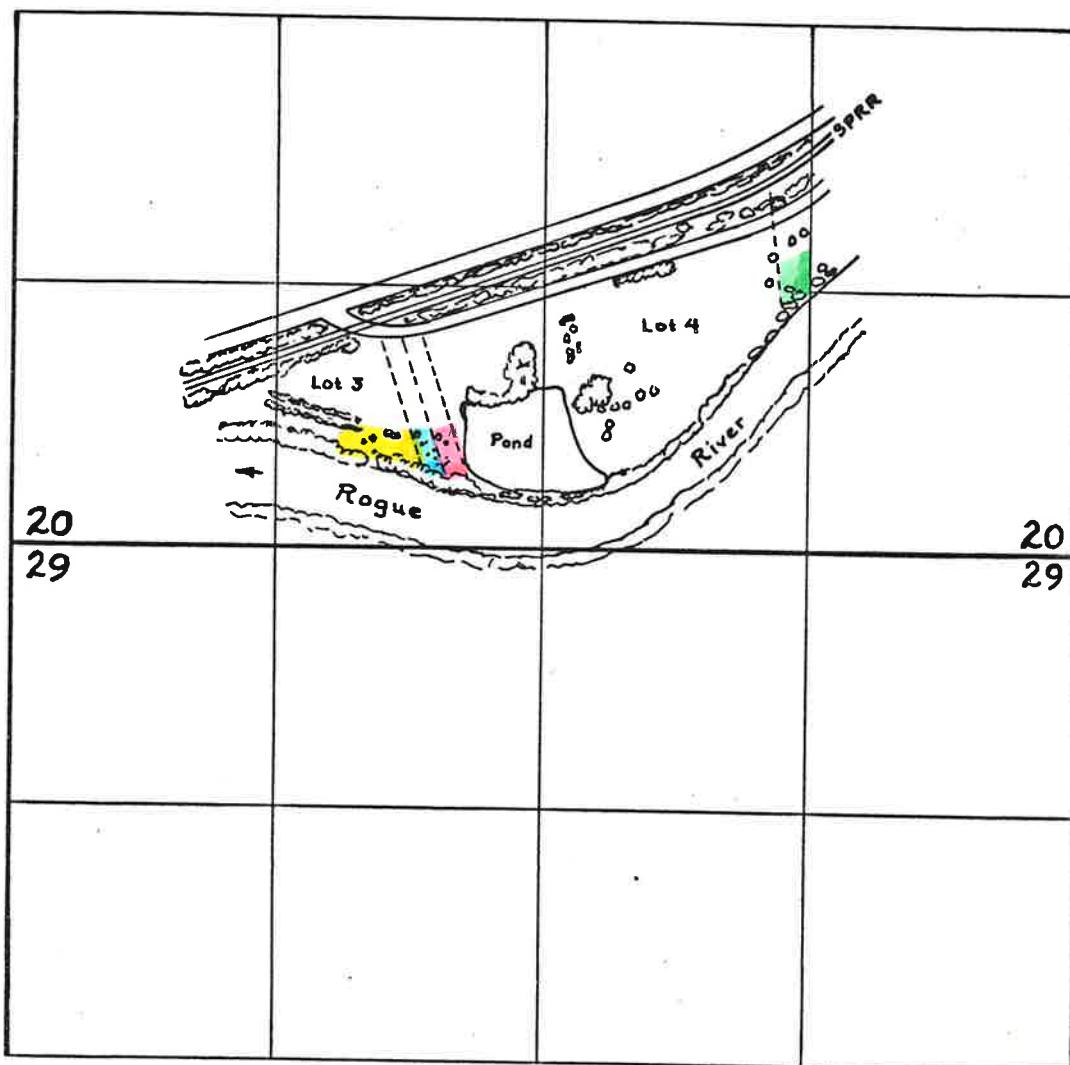

~~Certificate 2828~~ ³⁸³⁰⁸

~~Certificate 9533~~ ³⁸³⁰⁹

Lot 3

Lot 3

- Larson 0.5 Ac.
- Morrison 0.5 Ac.

- Wills, et al 1.7 Ac.

Lot 4

- Tucker 0.75 Ac.

Figure 1