


T. 1 S. R. 39 E. W. M.

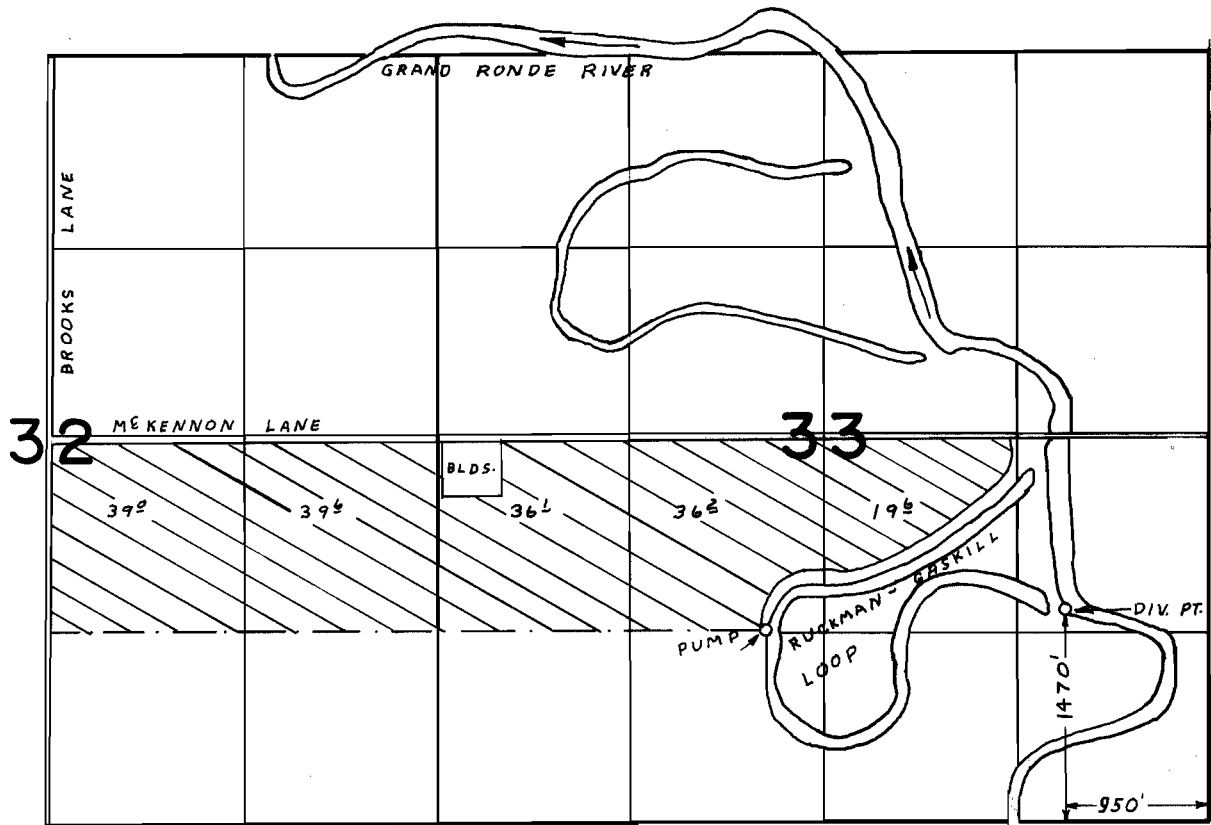

FINAL PROOF SURVEY UNDER

Application No. 40453. Permit No. 30845.

IN NAME OF

Thurman & Donna Teeter

Elwyn D. & Barbara Bingham

Surveyed JUL. 16. 1973, by R. MUCKEN.