


T. 38 S. R. 4 E. W.M.

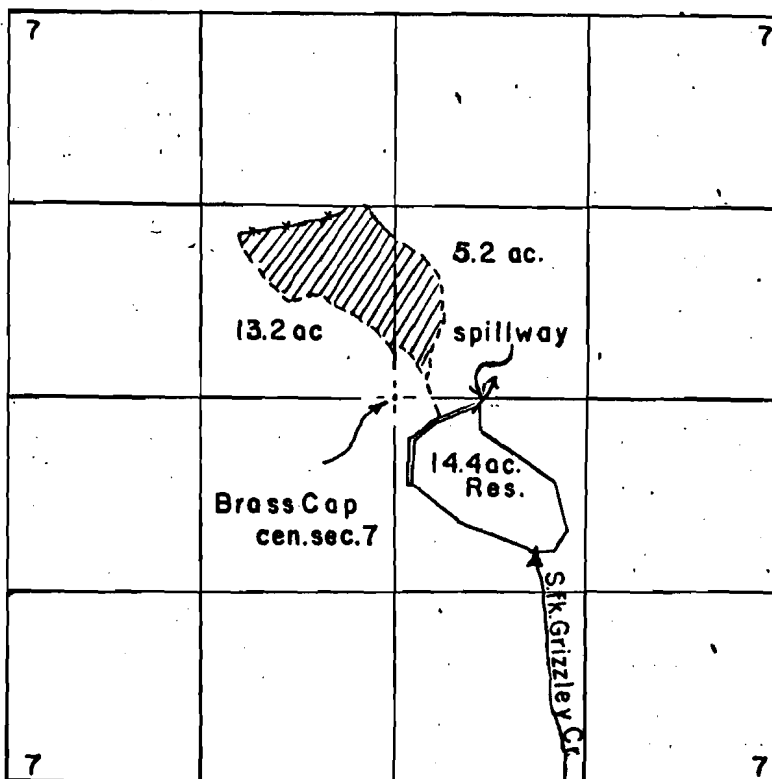

FINAL PROOF SURVEY UNDER

Application No. R-25815 ⁶⁰ Permit No. R-1162
IN NAME OF

.....Henry A. Owens.....

Surveyed May 21, 1963, by C.R. Baker.....