


T.38S.R.4E.W.M.

Grizzly Cr. & Res.

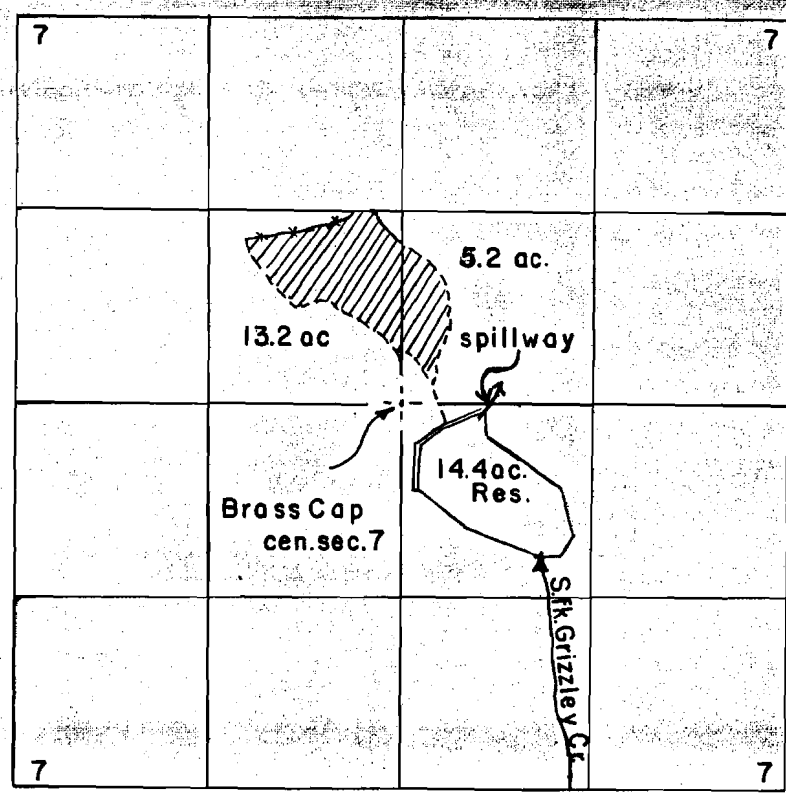

FINAL PROOF SURVEY
UNDER

Application No. R-25815 ⁶ Permit No. R-1162
IN NAME OF

.....Henry A. Owens.....

Surveyed May 21, 1963, by C.R. Baker.....