


T.36S., R.2 W., W.M.

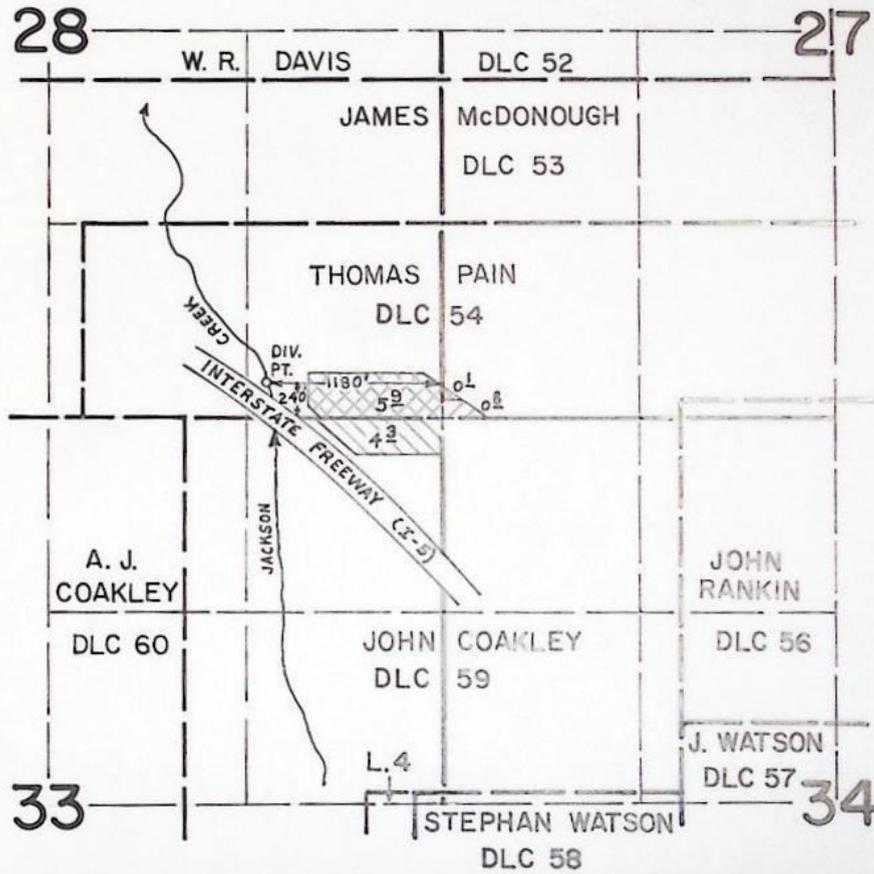

FINAL PROOF SURVEY UNDER

TRANSFER NO. 2844

Application No. Permit No.
IN NAME OF

GREAT VALLEY DEVELOPMENT CO.

Surveyed FEB. 4 19.83, by B. S. JAMES

SCALE: 4" = 1 MILE

- PRIMARY
- SUPPLEMENTAL